

Saline

KANSAS

Sec. 36 Twp. 15 R. 4W

Well No. #3 Burk Farm _____

Derby Oil Company _____

E. K. Carey - Contr. Contractor _____

Smoland Pool


Ft. from N. Line _____

330' Ft. from S. Line _____

Ft. from E. Line _____

990' Ft. from W. Line _____


SE SW SW

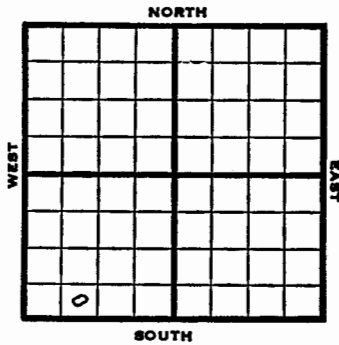

Section 36 Township 15 Range 4 W

Well No. # 3 Burk

Company Derby Oil

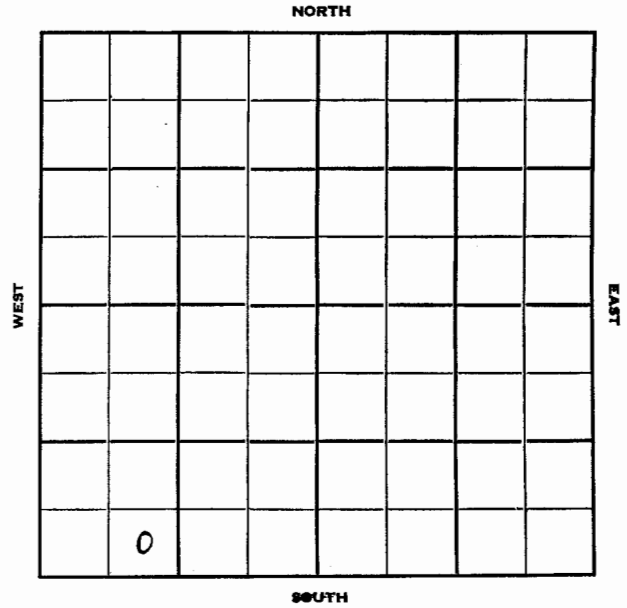

1951 Elev. 1328' REPORT

7/3 Location

8/15 Spud 7-4-51
 Oil well TD 3442' 8" @ 330'
 Maq. dol. 3439' TD 3442'
 4 1/2" @ 3440' FU 2900' oil overnite
 S/ 7 BOPH 250 A P/17 BOPH
 Comp. 571 BOPD
 COMPLETED