

County **Saline** State **Kansas**

Sec. **33** (Blk. Twp.) **15** (Sur. Rge) **437** Map No.

Operator Derby Oil

Well No. **2** Farm **Burk**

Elev. _____ Location **SE NE SW**

FIRST REPORT	
0	

990 Ft. From N Line SW

330 Ft. From E Line Quarter

1st. Report **JUN 20 1951**

Completion

Remarks :

Carey - Contr.

Spudding Date **6-19-51**

Drlg. Data **Ryding Pool**

Drlg. 290

J. E. TYRA

County Saline State Kansas

Sec.	36	(Blk. Twp.)	15	(Sur. Rge.)	4W	Map No.
------	----	----------------	----	----------------	----	---------

Operator Derby Oil

Well No. 2 Farm Burk

Elev.	1312	Location	SE NE SW
-------	------	----------	----------

COMPLETE

990 Ft. From N Line SW

330 Ft. From E Line Quarter

1st. Report _____

Completion AUG 8 1951

Remarks Ryding Pool

Carey - Contr.

Spudding Date 6-19-51

Drig. Data Oil well TD 3433

8" © 332 Miss. 2892 Kh. 3190

Hunton 3338 Mag. 3430-33 $4\frac{1}{2}''$ @ 3431

TD 3433 3 bfph 85% water S/ $2\frac{1}{2}$ bfph

50% water 16/ 3430-32 FU 1083' water

125' oil 14 hr. P/ 14 bo 1 bw 4 hr.

Comp. 124 bopd 6% water

J. E. TYRA

Saline

KANSAS

Sec. 36 Twp. 15 R. 4W

Well No. #2 Burk Farm

Derby Oil Company

Carey - Contr. Contractor

Ryding Pool


990' Ft. from N. Line

Ft. from S. Line

330' Ft. from E. Line

Ft. from W. Line

SE NE SW

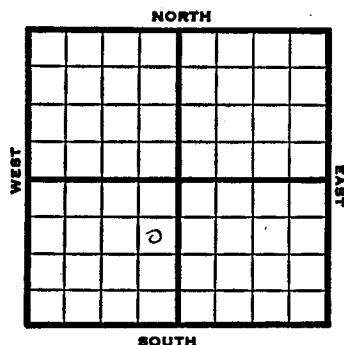


KANSAS

Section 36 Township 15 Range 4 W

Well No. # 2 Burk

Company Derby Oil

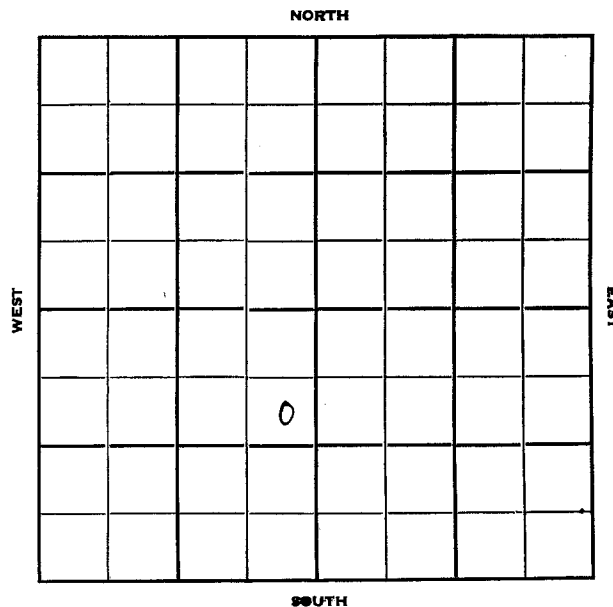

1951 Elev. 1312' REPORT

6/20 Spud 6-19-51
Drlg. 290'

8/8 Spud 6-19-51
Oil Well TD 3433
8" @ 332
Miss 2892 Kh 3190
Hunton 3338 Mac 3430-33
4 1/2" @ 3431 TD 3433
3 bfph 85% wtr S/2 1/2 bfph
50% wtr 16/3430-32 FU 1083' wtr
125' oil 14 hr. P/14 bo 1 bw 4 hrs.
Comp. 124 bopd 6 1/2 wtr.

COMPLETED