

County Saline State Kansas

Sec. 36 (Bk. 15 (Sur. 4W Map No.

Operator Derby Oil

Well No. 1 Farm Burk

Elev. Location SWSW 8W

330 Ft. From S Line SW	
330 Ft. From W Line Quarter	
1st. Report <u>MAY 23 1951</u>	
Completion <u> </u>	
Remarks <u>Carey Drlg. - Contr.</u>	
Spudding Date <u>5-21-51</u>	

Drlg. Data Ryding Pool

8" @ 320 WOC

J. E. TYRA

County Saline State Kansas

Sec. 36 (Bk. 15 (Sur. 4W Map No.

Operator Derby Oil

Well No. 1 Farm Burk

Elev. 1327 Location SW SW SW

330Ft. From S Line SW	
330Ft. From W Line Quarter	
1st. Report <u> </u>	
Completion <u>JUL 11 1951</u>	
Remarks <u>Ryding Pool</u>	
Carey Drlg. - Contr.	
Spudding Date <u>5-21-51</u>	

Drlg. Data Oil well TD 3438

8" @ 320 Miss. 2910 Kh. 3206

Hunton 3356 Maq. sh. 3368

Maq. dol. 3433 DST 3434-38

open 30 min. Rec. 1200' gas 365'

oil 5 1/2" @ 3434 TD 3438 S/ 14 bopd

300 A P/ 17 bopd Comp. 1314 bopd

J. E. TYRA

Saline
15

KANSAS 4W ✓

Sec. 36 Twp. R.

Well No. #1 Burk Farm

Derby Oil Company

Carey Drlg. - Contr. Contractor
Ryding Pool


Ft. from N. Line

330' Ft. from S. Line

Ft. from E. Line

330' Ft. from W. Line

SW SW SW

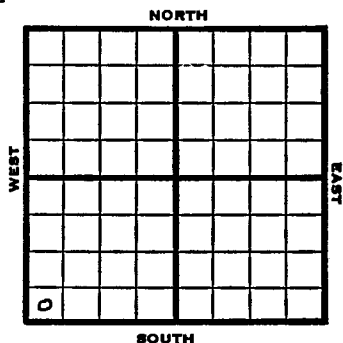


Saline

KANSAS

Section 36 Township 15 Range 4W

Well No. #1 Burk

Company Derby Oil

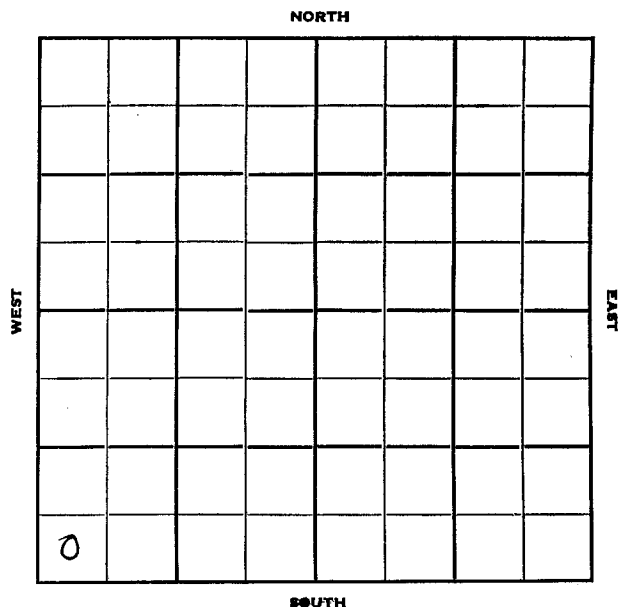

1951 Elev. 1327' REPORT

5/23 Spud 5-21-51
8" @ 320
WOC

7/11 Spud 5-21-51
Oil Well TD 3438
8" @ 320
Miss 2910 Kh 3206
Hunton 3356 Maq.sh 3368
Maq. dol. 3433
IST 3434-38 opn 30 min.
Rec. 1200' gas 365' oil 4 1/2" @
3434 TD 3438 S/14 boph 300 A
P/17 boph Comp. 1314 bopd

COMPLETED