

Saline KANSAS
Sec. 36 Twp. 15 R. 14W

Saline KANSAS

Section 36 Township 15 Range 14W

Well No. 6 Bengston Farm


Well No. 6 Bengston

Republic Natural Company

Company Republic Natural

Carey Drlg - Contr. Contractor
Smolan Pool

Ft. from N. Line

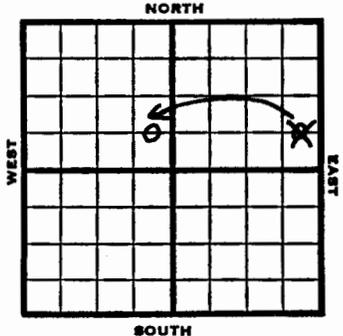


660 Ft. from S. Line

330 Ft. from E. Line

Ft. from W. Line

~~C E L S E N W~~

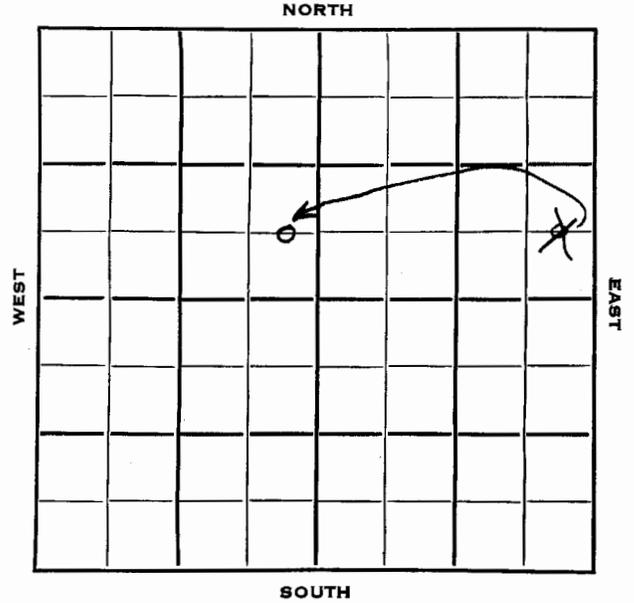

1953 Elev. 1311' REPORT

4/1 R U R
 4/9 10" @ 365'
 Drlg 1610'

4/16 Drlg. 3223'
 4/23 V 3425'
 4/30 RTD 3468
 5" @ 3468, gamma-ray
 2 1/4 / 3425-29, 1000A
 S/8-3/4 BOPH 1 hr.
 S/13 BOPH after 6 hrs.

5/7 NR
 5/21 NR
 5/27 Spud 3-30-53
 Oil Well
 TD 3468'
 10" @ 365'
 Kh. 3188, Hunton 3344, Viola 3425,
 TD 3468
 5" @ 3468'
 2 1/4 / 3425-29 1000 A S/ 8 3/4 boph
 S/ 13 boph Compl 81 bopd 10% wtr.

COMPLETED