


County Saline State Kansas
 Sec. 36 (Blk. 15 (Sur. 4W Map No.
 Operator Republic Natural
 Well No. 5 Farm Bengston
 Elev. _____ Location C NE NW

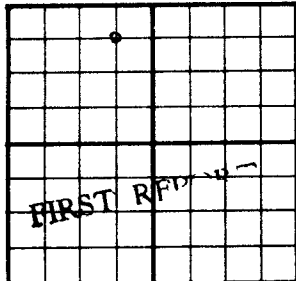


660 Ft. From N Line NW
660 Ft. From E Line Quarter
 1st. Report MAR 1 1 1953
 Completion _____
 Remarks _____
Carey Drlg. - Contr.
 Spudding Date _____

Drlg. Data

WCC

J. G. McGEHEE

County Saline State Kansas
 Sec. 36 (Blk. 15 (Sur. 4W Map No.
 Operator Republic Natural
 Well No. 5 Farm Bengston
 Elev. 1300 Location C NE NW

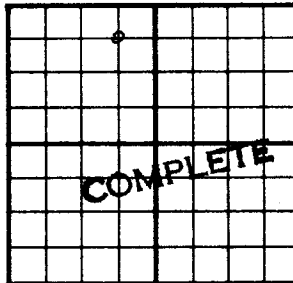

660 Ft. From N Line NW
660 Ft. From E Line Quarter
 1st. Report _____
 Completion MAY 13 1953
 Remarks _____
Carey Drlg. - Contr.
 Spudding Date 3-15-53

Drlg. Data Oil well TD 3455

10" C 365 Rh. 3178 Hunton 3323

Mag. sh. 3336 Viola 3407 TD 3455

5" C 3443 30/ 3408-12 1000 A

S/ 44 bo 4 hr. Comp. 13 bopd

J. G. McGEHEE

Saline KANSAS ✓


Sec. 36 Twp. 15 R. 4 WWell No. # 5 Bengston FarmRepublic Natural CompanyCarey Drlg. Contractor660 Ft. from N. Line

Ft. from S. Line

660 Ft. from E. Line


Ft. from W. Line

C NE NW

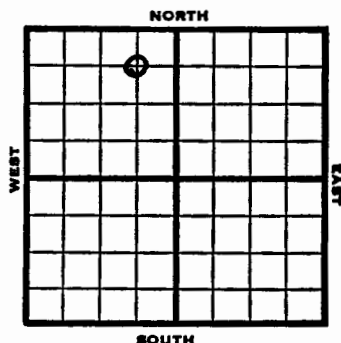

Saline

KANSAS

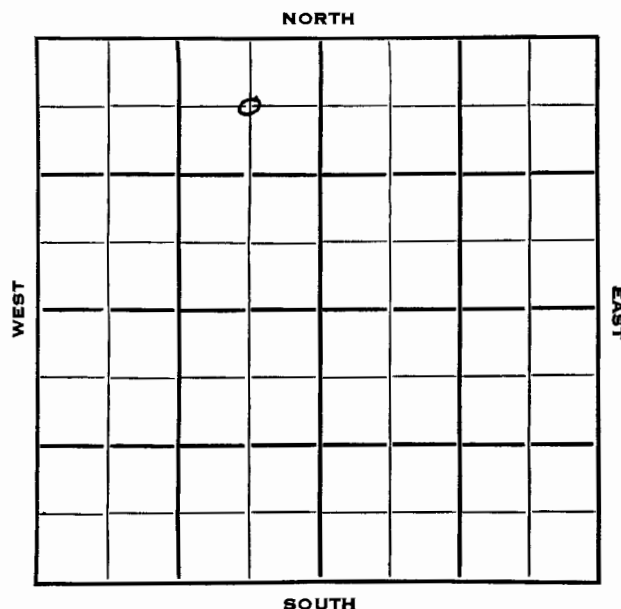Section 36 Township 15 Range 4WWell No. #5 BengstonCompany Republic Natural Gas Company

1953 Elev. 1300' REPORT

3/11 WOC

3/19 10" @ 365'

3/26 Drlg. 2580'

4/2 V 3407' RTD 3455 5" @ 3443

4/9 30/ 3408-12 1000A S/ 44 BO 4 Hrs.

4/16 POP

4/23 POP

4/30 NR

5/7 NR

5/13 Spud 3-15-53

Oil Well

TD 3455'

10" @ 365'

Kh 3178, Hunton 3323, Maq. sh. 3336',

Viola 3407.

TD 3455'

5" @ 3443'

30/ 3408-12 1000 A S/ 44 bo 4 hr.

Comp. 13 bopd.

COMPLETED