

County	Saline	State	Kansas
Sec.	36 (Blk. Twp.)	15 (Sur. Rge.)	4W Map No.
Operator	Republic Natural		
Well No.	4	Farm	Bengston
Elev.	Location C W $\frac{1}{2}$ W $\frac{1}{2}$ NW		
	1320 Ft. From N Line NW		
	330 Ft. From W Line Quarter		
	1st. Report FEB 25 1953		
	Completion		
	Remarks		
	Carey Drlg. - Contr.		
	Spudding Date 2-23-53		
Drig. Data	Smolan Pool		

J. G. McGEHEE

County	Saline	State	Kansas
Sec.	36 (Blk. Twp.)	15 (Sur. Rge.)	4W Map No.
Operator	Republic Natural		
Well No.	4	Farm	Bengston
Elev.	1303	Location C W $\frac{1}{2}$ W $\frac{1}{2}$ NW	
	1320 Ft. From N Line NW		
	330 Ft. From W Line Quarter		
	1st. Report		
	Completion APR 29 1953		
	Remarks Smolan Pool		
	Carey Drlg. - Contr.		
	Spudding Date 2-23-53		
Drig. Data	Oil well	TD 3465	

15" @ 100 10" @ 362 Kh. 3180
 Hunton 3324 Mag. 3330 Viola 3409 7" @ 3465
 TD 3465 CC to 3459 PB 3427 42/ 3410-14
 1000 A S/ 11 boph 7 hr.
 Comp. 154 bopd 5% wtr.

J. G. McGEHEE

Saline KANSAS

Sec. 36 Twp. 15 R. 4 WWell No. # 4 Bengston FarmCompany Republic NaturalContractor Carey Drlg.

Smolan Pool


1320 Ft. from N. Line

Ft. from S. Line

Ft. from E. Line

330 Ft. from W. Line

C W/2 W/2 NW

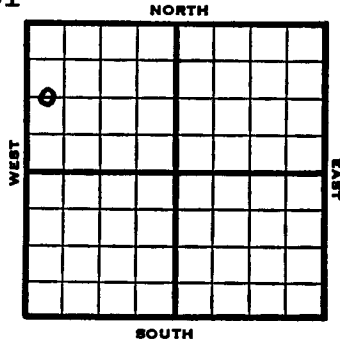

1953 Elev. 1303' REPORT

2/25 Spud 2-23-53

3/12 Drlg. 3000'

3/19 V 3415' RTD 3465 7" @ 3465

3/26 CO 3459 NS

PB 3427, 42/3410-14, 1000A

S/11 BOPH 7 hrs., POP

Schl Tops: KH 3180, Htn 3324,

Maq 3330, V 3409

4/2 "

4/9 NR

4/16 NR

4/23 NR

4/29 Spud 2-23-53

Oil Well

TD 3465

15" @ 100

10" @ 362

Kh 3180, Hunton 3324, Maq. 3330, Viola 3409

7" @ 3465

TD 3465

CO to 3459

PB 3427, 42/3410-14, 1000A

S/11 boph 7 hrs.

Comp. 154 bopd 5% wtr.

COMPLETED

Saline

KANSAS

Section 36 Township 15 Range 4WWell No. #4 BengstonCompany Republic Natural