


County Saline State Kansas
 Sec. 36 (Blk. 15 (Sur. 4W Map No.
 Operator E. K. Carey
 Well No. 3 Farm Bengston
 Elev. Location C S/2 S/2 NW

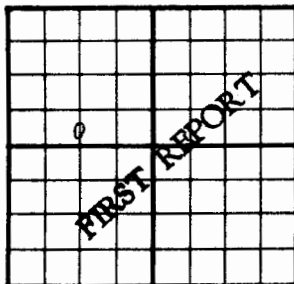


330 Ft. From S Line NW
1320 Ft. From W Line Quarter
 Ist. Report APR 2 1952
 Completion
 Remarks
Carey - Contr.
 Spudding Date

Drig. Data Smolin

MIR

J. G. McGEHEE

County Saline State Kansas
 Sec. 36 (Blk. 15 (Sur. 4W Map No.
 Operator E. K. Carey
 Well No. 3 Farm Bengston
 Elev. 1319 Location C S L S $\frac{1}{2}$ NW

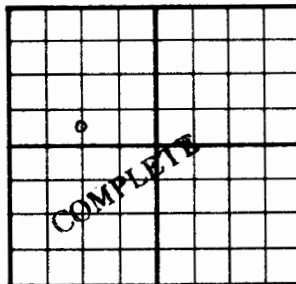

330 Ft. From S Line NW
1320 Ft. From W Line Quarter
 Ist. Report
 Completion JUN 18 1952
 Remarks Smolan Pool
Carey - Contr.
 Spudding Date 4-1-52

Drig. Data Oil well TD 3433

8" @ 327 Lens. 2260 Miss. 2914

Kh. 3200 Hunton 3348 Maq. sh. 3368

Maq. dol. 3430 TD 3433 5" @ 3431

CO to 3433 S/ 21 boph Comp. 224 bopd

J. G. McGEHEE

Saline

KANSAS

✓

Sec. 36 Twp. 15 R. 4 W

Well No. # 3 Bengston Farm

E. K. Carey Company

Carey Contractor

Smolin


Ft. from N. Line

330 Ft. from S. Line

Ft. from E. Line

1320 Ft. from W. Line

C S/2 S/2 NW

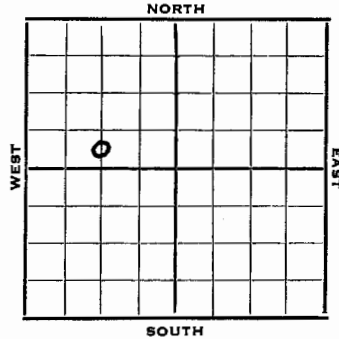


KANSAS

Section 36 Township 15 Range 4W

Well No. #3 Bengston

Company E. K. Carey

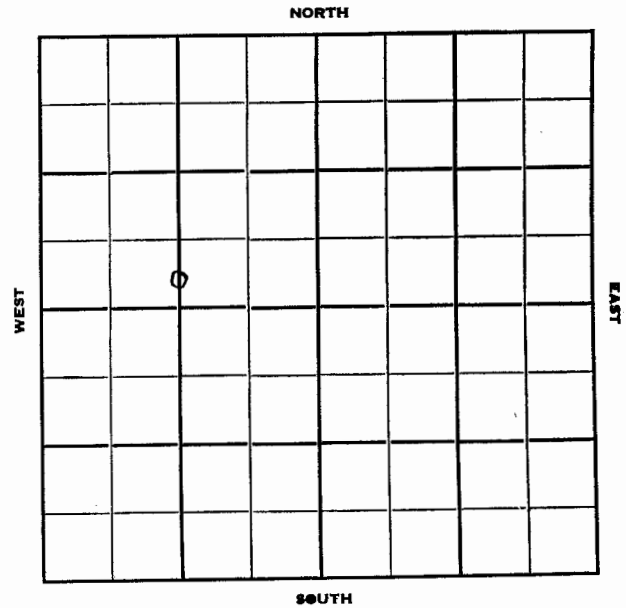

1952 Elev. 1319' REPORT

4/2 MIR
4/8 8" @ 327 Lans. KC 2260
Drlg. 2450'
4/23 Miss 2914' KH 3200' Htn 3348'
Mq shale 3368' Mq Dol 3430'
RTD 3433' 5" @ 3431' WOC
4/30 DP CO 3433 S/ 21 BOPH for 3 hrs.
300' off btm. POP
5/7 NR
5/14 "
5/21 "
5/28 "
6/11 "
6/18 Spud 4-1-52
Oil Well TD 3433 8" @ 327
Lans. 2260 Miss 2914
Kh 3200 Hun 3348
Maq. sh 3368 Maq. dol. 3430
TD 3433 5" @ 3431 CO to 3433
S/ 21 boph Comp. 224 bopd

COMPLETED