

County Saline State Kans.
Sec. 36 (Bk.) 15 (Sur.) 4 W Map No.

Operator E. K. Carey
Well No. 2 Farm Bengston
Elev. _____ Location SW SW NW

0					

330 Ft. From S Line NW
330 Ft. From W Line Quarter
1st. Report AUG 22 1951
Completion _____
Remarks _____

Spudding Date _____

Drig. Data Smolan Pool

Location _____

J. E. TYRA

County	Saline	State	Kansas
Sec.	36 (Bk. Twp.)	15 (Sur. Rge.)	4W Map No.
Operator	E. K. Carey		
Well No.	2	Farm	Bengston
Elev.	1305	Location	SW SW NW
		330 Ft. From	S Line NW
		330 Ft. From	W Line Quarter
		1st. Report	
		Completion	OCT 3 1951
		Remarks	Smolan Pool
Spudding Date		8-25-51	

Drig. Data	Oil well	TD 3418
8" @ 324	Miss. 2892	Kh. 3192
Hunton 3340	Mag. sh. 3350	Mag. dol. 3416-
18 5" @ 3416	TD 3418	S/ 9 boph 3 hr.
1000 A	Comp. 1256 bopd	

J. E. TYRA

Saline

KANSAS

Sec. 36 Twp. 15 R. 4W

Well No. #2 Bengston Farm

E. K. Carey Company

Contractor

Smolan Pool


Ft. from N. Line

330' Ft. from S. Line

Ft. from E. Line

330' Ft. from W. Line

SW SW NW

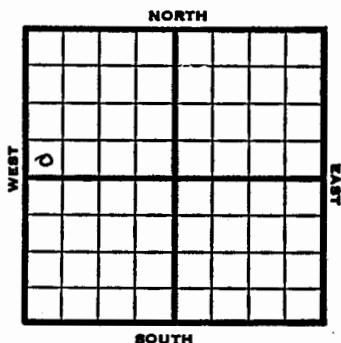

1951 Elev. 1305' REPORT

8/22 Location

10/3 Spud 8-25-51

Oil well TD 3418' 8" @ 324'
Miss 2892' Kh. 3192' Hunton 3340'
Maq. sh. 3350' Maq. dol. 3416-18'
5" @ 3416' TD 3418' S/9 BOPH
3 hr. 1000 A
Comp. 1256 BOPD

COMPLETED

KANSAS

Section 36 Township 15 Range 4W

Well No. #2 Bengston

Company E.K. Carey

