


County Saline State Kansas
 Sec. 36 (Blk.) 15 (Sur.) 4W Map No.
 Operator E. K. Carey
 Well No. 1 Farm Bengston
 Elev. _____ Location NE NE NE

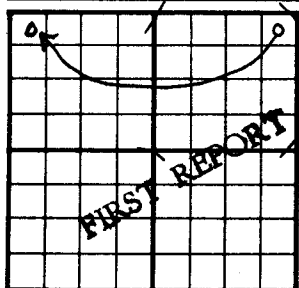

330 Ft. From N Line NE
330 Ft. From N Line Quarter

1st. Report MAY 23 1951

Completion _____

Remarks _____

Spudding Date _____

Drig. Data Ryding Pool

M I R

J. E. TYRA

Form 26 200 Bks. 8-50 Petrol

Kansas

Map No. _____ Sec. 36 Twp. 15 R. 4W

Well No. 1 Bengston

E. K. Carey Company

CORRECTION

Contractor

NW NW NW

SECTION PLAT

330 Ft. from N. Line

Ft. from S. Line

Ft. from E. Line

330 Ft. from W. Line

0			

Saline County

Location _____

Rig up _____

Drilling and Remarks:

Reported

NE NE NE

RECORD

Cased _____ in., _____ ft.

Sand _____

Gas _____

Oil _____

Total Depth _____

PRODUCTION

1st 24 hrs. Nat. _____

1st 24 hrs. after shot _____

Gas _____ Cu. Ft.

Dry Hole _____

Abandoned _____

Date

MAY 29 1951

J. E. TYRA

Scout

Saline

KANSAS

Sec. 36 Twp. 15 R. 4W

Well No. #1 Bengston Farm

E. K. Carey Company

Contractor

Ryding Pool

330' Ft. from N. Line


Ft. from S. Line

330' Ft. from E. Line

330 Ft. from W. Line

NW NW NW

NE NE NE

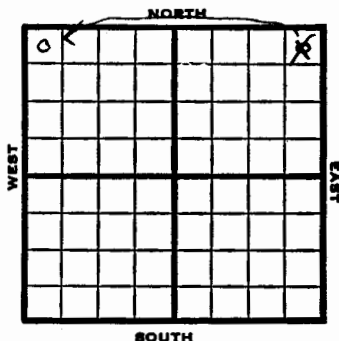

1951 Elev. 1302' REPORT

5/23 MIR

7/3 Oil well TD 3423' 8" @ 333
Miss. 2898' Kh. 3185' Misenor 3323'
Hunton 3332' Mag. 3343' Dol 3417'
DST 3418-23 open $\frac{1}{2}$ hr. rec 1440' gas
540' free oil, 30' water
TD 3423' 5" @ 3418'
Comp. 497 BOPD

COMPLETED

Saline KANSAS

Section 36 Township 15 Range 4W

Well No. #1 Bengston

Company E. K. Carey

