


County **Saline** State **Kansas**
 Sec. **36** (Blk. **15** (Sur. **4W** Map No.
 Operator **Sheldon & West**
 Well No. **3** Farm **Bengston (B)**
 Elev. Location **NW NE SE**

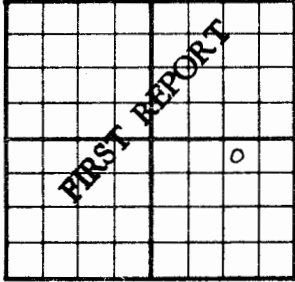


330 Ft. From **N** Line **SE**
990 Ft. From **E** Line Quarter
 1st. Report **FEB 13 1952**
 Completion
 Remarks
Shields - Contr.
 Spudding Date **2-9-52**

Drig. Data

8" @ 339 Drig. 725

J. G. McGEHEE

County **Saline** State **Kansas**
 Sec. **36** (Blk. **15** (Sur. **4W** Map No.
 Operator **Sheldon & West**
 Well No. **3** Farm **Bengston "B"**
 Elev. **1307** Location **NW NE SE**

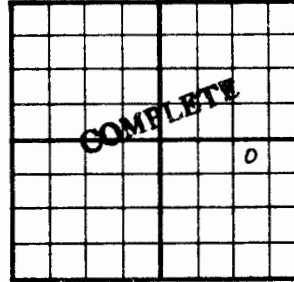

330 Ft. From **N** Line **SE**
990 Ft. From **E** Line Quarter
 1st. Report
 Completion **APR 9 1952**
 Remarks
Shields - Contr.
 Spudding Date **2-9-52**

Drig. Data **Oil well TD 3421**

8" @ 339 Miss. 2908 Misener 3340

Hunton 3341 Maq. sh. 3351 Dol. 3419-21

5" @ 3419 TD 3421 S/ 100 bo 3 hr.

Comp. 206 bopd 25% water

J. G. McGEHEE

Saline

KANSAS

4W

Sec. 36 Twp. 15 R. 4W

Well No. #3 Bengston (B) Farm

Sheldon & West Company

Shields Contractor


330 Ft. from N. Line

Ft. from S. Line

990 Ft. from E. Line

Ft. from W. Line

NW NE SE

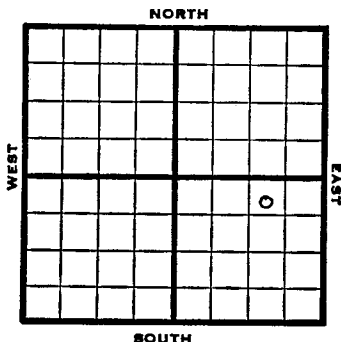

1952 Elev. 1307' REPORT

2/13 Spud 2-9-52
8" @ 339'
Drlg. 725'

2/20 Miss 2902'
Drlg. 2997'

3/5 S/100 BO 3 hrs.

3/11 POP

3/19 "

3/25 "

4/1 "

4/9 Spud 2-9-52
Oil Well TD 3421
8" @ 339 Miss. 2908 Misener 3340
Hunton 3341 Maq. sh 3351
Dol. 3419-21
5" @ 3419 TD 3421
S/ 100 bo 3 hr.
Comp. 206 bopd 25% wtr.

COMPLETED

Section 36 Township 15 Range 4 W

Well No. # 3 Bengston (B)

Company ~~XX~~ Sheldon & West

