

County Saline State Kansas
 Sec. 36 (Blk.) 15 (Sur.) 4W Map No.
 Operator Sheldon Bros. etal.
 Well No. 2 Farm Bengston
 Elev. _____ Location NE NW SE




330 Ft. From N Line SE
990 Ft. From W Line Quarter
 1st. Report SEP 12 1951
 Completion _____
 Remarks _____
Honaker Drlg. - Contr.
 Spudding Date _____

Drlg. Data _____ Smolan Pool

Cellar & pits

J. E. TYRA

County Saline State Kansas
 Sec. 36 (Blk.) 15 (Sur.) 4W Map No.
 Operator Sheldon Bros. etal.
 Well No. 2 Farm Bengston
 Elev. 1305 Location NE NW SE

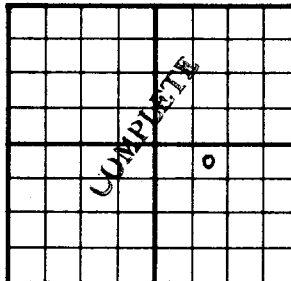

330 Ft. From N Line SE
990 Ft. From W Line Quarter
 1st. Report _____
 Completion OCT 24 1951
 Remarks Smolan Pool
Honaker Drlg. - Contr.
 Spudding Date 9-13-51

Drlg. Data Oil well TD 3418

13" @ 86 8" @ 341 Miss. 2902

Misener 3326 Hunton 3328 Maq. sh. 3340

Maq. dol. 3417 TD 3418 5" @ 3417

CO to 3418 S/ 15 boph FU 2318' oil 16 h

Comp. 738 bopd 3% water

J. E. TYRA

Saline

KANSAS

Sec. 36 Twp. 15 R. 4 W ✓

Well No. # 2 Bengston Farm

Sheldon Bros. et al Company

Honaker Drlg. Contractor

Smolan Pool


330 Ft. from N. Line

Ft. from S. Line

Ft. from E. Line

990 Ft. from W. Line

NE NW SE

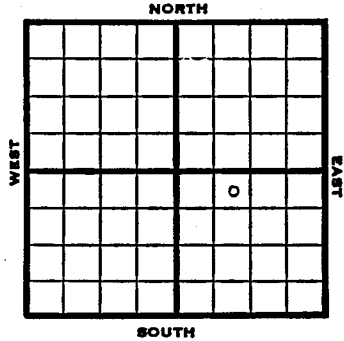

1951 Elev. 1305' REPORT

9/12 Cellar & Pits
10/24 Spud 9-13-51
Oil Well TD 3418
13" @ 86 8" @ 341
Miss. 2902 Misener 3326
Hunton 3328 Mag. sh. 3340
Mag. dol. 3417 TD 3418
5" @ 3417 CO to 3418
S/ 15 BOPH Fu 2318' oil
16 hr.
Comp. 738 BOPD 3% wtr.

COMPLETED

KANSAS

Section 36 Township 15 Range 4W

Well No. #2 Bengston

Company Sheldon Bros. et al

