

County Saline State Kansas  
 Sec. 36 (Blk. 15) (Sur. Rge. 4W) Map No. \_\_\_\_\_  
 Operator Sheldon Bros.  
 Well No. 1 Farm Bengston  
 Elev. \_\_\_\_\_ Location NW NW SE  
 550 Ft. From N Line SE  
 380 Ft. From W Line Quarter  
 1st. Report APR 18 1951  
 Completion \_\_\_\_\_  
 Remarks \_\_\_\_\_  
 Spudding Date \_\_\_\_\_

Drlg. Data

WildcatLocation

Form 26 200 Bks. 8-50 Petrol

Kansas

Map No. \_\_\_\_\_ Sec. 36 Twp. 15 R. 4W  
 Well No. 1 Bengston

Sheldon Bros.

Company

CORRECTION

Contractor

SW NW SE

## SECTION PLAT

|  |  |  |  |
|--|--|--|--|
|  |  |  |  |
|  |  |  |  |
|  |  |  |  |
|  |  |  |  |

990 Ft. from N. Line

Ft. from S. Line

Ft. from E. Line

330 Ft. from W. LineSaline County

Location \_\_\_\_\_

Rig up \_\_\_\_\_

Drilling and Remarks:

Reported

NW NW SE

## RECORD

Cased \_\_\_\_\_ in., \_\_\_\_\_ ft.

Sand \_\_\_\_\_

Gas \_\_\_\_\_

Oil \_\_\_\_\_

Total Depth \_\_\_\_\_

## PRODUCTION

1st 24 hrs. Nat. \_\_\_\_\_

1st 24 hrs. after shot \_\_\_\_\_

Gas \_\_\_\_\_ Cu. Ft.

Dry Hole \_\_\_\_\_


Abandoned \_\_\_\_\_

Date

MAY 2 195119J. E. TYRA

Scout

J. E. TYRA
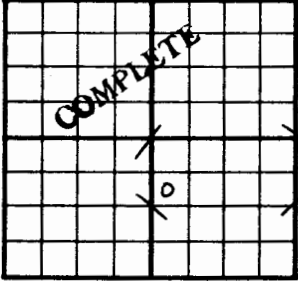
|                                                                                   |               |                             |          |             |            |
|-----------------------------------------------------------------------------------|---------------|-----------------------------|----------|-------------|------------|
| County                                                                            | Saline        |                             | State    | Kansas      |            |
| Sec.                                                                              | 36            | (Blk. Twp.)                 | 15       | (Sur. Rge.) | 4W Map No. |
| Operator                                                                          | Sheldon Bros. |                             |          |             |            |
| Well No.                                                                          | 1             | Farm                        | Bengston |             |            |
| Elev.                                                                             | 1313          | Location                    | SW NW SE |             |            |
|  |               | 990 Ft. From N Line         |          | SE          |            |
|                                                                                   |               | 330 Ft. From W Line         |          | Quarter     |            |
|                                                                                   |               | 1st. Report                 |          |             |            |
|                                                                                   |               | Completion JUN 20 1951      |          |             |            |
|                                                                                   |               | Remarks Wildcat             |          |             |            |
|                                                                                   |               | Anschutz - Contr.           |          |             |            |
|                                                                                   |               | Spudding Date 5-3-51        |          |             |            |
|                                                                                   |               | Drig. Data Oil well TD 3427 |          |             |            |
| 13" @ 150 8" @ 310 Miss. 2904                                                     |               |                             |          |             |            |
| Kh 3190 Misenor 3334 Hunton 3336                                                  |               |                             |          |             |            |
| Maq. 3347 Dol. 3421 DST 3423-26                                                   |               |                             |          |             |            |
| open $\frac{1}{2}$ hr. Rec. 150' oil 160' o & gcm                                 |               |                             |          |             |            |
| 5" @ 3423 TD 3427 FU 1000' oil 1 hr.                                              |               |                             |          |             |            |
| P/ 25 boph 500 A Comp. 208 bopd 26% w                                             |               |                             |          |             |            |

J. E. TYRA

Saline

KANSAS

Sec. 36 Twp. 15 R. 4W ✓

Well No. #1 Bengston Farm

Sheldon Bros Company

Anschutz - Contr. Contractor


990 Wildcat  
330 Ft. from N. Line

Ft. from S. Line

Ft. from E. Line

330 Ft. from W. Line

SW NW SE  
NW NW SE

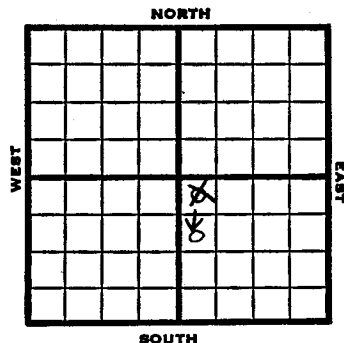


Saline

KANSAS

Section 36 Township 15 Range 4W

Well No. #1 Bengston

Company Sheldon Bros.

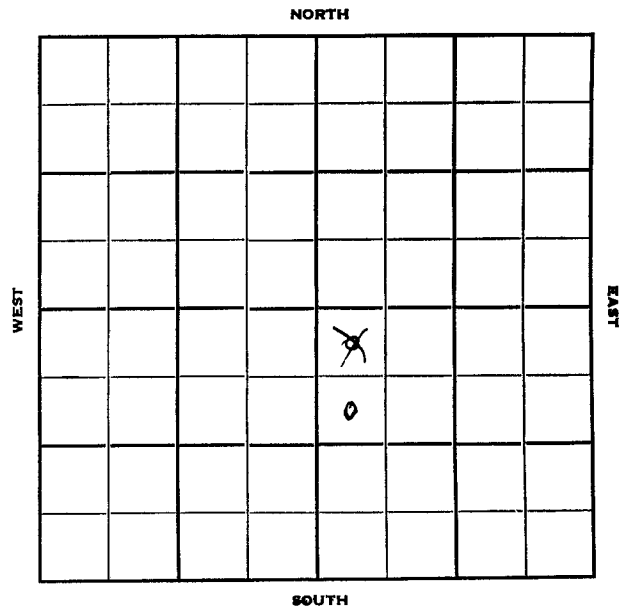

1951 Elev. 1313 REPORT

4/18 Location

6/20 Spud 5-3-51  
Oil Well TD 3427  
13" @ 150 8" @ 310  
Miss 2904 Kh 3190  
Misenor 3334 Hunton 3336  
Maq. 3347 Dol. 3421  
DST 3423-26 opn 1/2 hr.  
Rec. 150' oil 160' o & gcm  
5" @ 3423 TD 3427  
FU 1000' oil 1 hr  
P/25 boph 500 A Comp. 208 bopd  
26% w

**COMPLETED**