


KANSAS Russell county

Section 4 Township 15 Range 12W

Well No. #3, Kuhnle

Company Eldorado Ref.

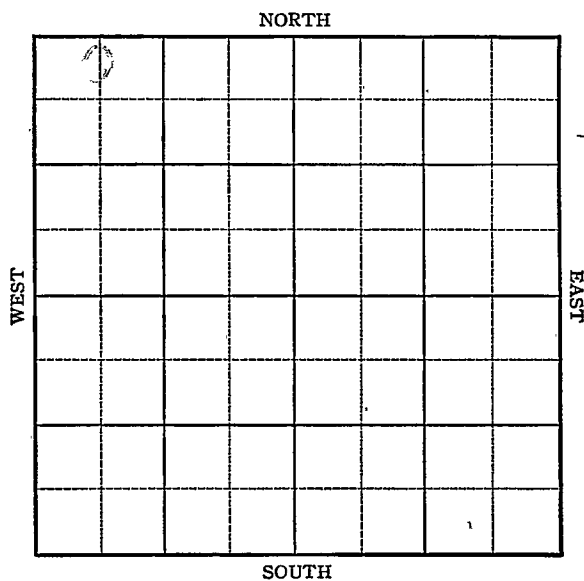

KANSAS

Sec. 4 - Twp. 15 R. 12W

Well No. #3 Kuhnle Farm

Eldorado Ref. Company

Hall-Gurney

330


Ft. from N. Line

Ft. from S. Line

Ft. from E. Line

660

Ft. from W. Line

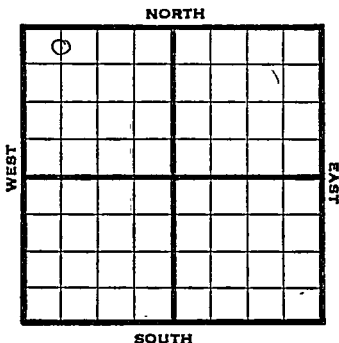

CNL NW NW

1946

REPORT

6/5 Location

6/12 "

6/18 "

6/26 "

7/3 "

7/9 "

7/16 "

7/24 Abandoned location

ABANDONED

KANSAS

Kansas Pool Name Hall-GurneyMap No. 53 Sec. 4 Twp. 15 R. 12WWell No. 3 Kuhnle

Eldorado Ref.

Company

FIRST REPORT

Contractor

C N L NW NW

SECTION PLAT

330 Ft. from N. Line Ft. from S. Line Ft. from E. Line660 Ft. from W. Line

0			

Russell County

Location XRig up

Drilling and Remarks:

RECORD

Cased in., ft.Sand Gas Oil Total Depth

PRODUCTION

1st 24 hrs. Nat. 1st 24 hrs. after shot Gas Cu. Ft.Dry Hole Abandoned

Date

JUN 5 1946 19S. J. LEWIS Scout

Pool Name Hall-Gurney PoolKANSAS ~~Kansas~~
Map No. 53 Sec. 4Twp. 15 R. 12WWell No. 3 Kuhnle

Eldorado Ref.

Company

ABANDONED

Contractor


C N L NW NW

SECTION FLAT

330 Ft. from N. Line

Ft. from S. Line

Ft. from E. Line

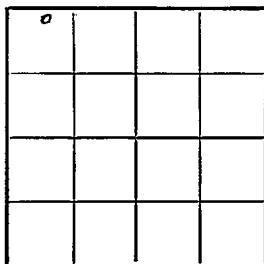660 Ft. from W. Line

Russell County

Location ✓

Rig up

Drilling and Remarks:

RECORD

Cased _____ in., _____ ft.

Sand _____

Gas _____

Oil _____

Total Depth _____

PRODUCTION.

1st 24 hrs. Nat. _____

1st 24 hrs. after shot _____

Gas _____ Cu. Ft.

Dry Hole _____

Abandoned Loc

Date

JUL 24 1946

19

S. J. LEWIS

Scout