PLEASE KEEP CONFIDENTIAL

SIDE ONE

S

STATE CORPORATION COMMISSION OF KANSAS
OIL & GAS CONSERVATION DIVISION

WELL COMPLETION OR RECOMPLETION FORM
ACO-1 WELL HISTORY

DESCRIPTION OF WELL AND LEASE

Operator: License # KCC 8458
Name Trans-Western Operating Co.
Address 1228 15th Street
Suite 400
City/State/Zip Denver, Colorado 80202

Purchaser Permian Corp.
5800 E. Shell Drive
Tulsa, Oklahoma 74735

Operator Contact Person H. Wayne Stack
Phone (303) 839-1664

Contractor: License # KCC 60#3
Name Murfin Drilling Co.

Wellsite Geologist Russel Bak
Phone (303) 457-0042

Designate Type of Completion
[X] New Well [ ] Re-Entry [ ] Workover

[X] Oil [ ] SWD [ ] Temp Abd
[ ] Gas [ ] Inj [ ] Delayed Comp.
[ ] Dry [ ] Other (Core, Water Supply etc.)

If OWWO: old well info as follows:
Operator
Well Name
Comp. Date Old Total Depth

WELL HISTORY

Drilling Method:
[X] Mud Rotary [ ] Air Rotary [ ] Cable

2-18-86	2-24-86	3-7-86
Spud Date	Date Reached TD	Completion Date
5300'	5234'	
Total Depth	PBTD	

Amount of Surface Pipe Set and Cemented at 384 feet
Multiple Stage Cementing Collar Used? [X] Yes [ ] No
If yes, show depth set 2696 feet
If alternate 2 completion, cement circulated
from 2696 feet depth to surf w/ 500 SX cmt

API NO. 15- 199-20,076

County Wallace

SW .SE .NE Sec. 32 Twp 15S Rge 42 [ ] East [X] West

2970 Ft North from Southeast Corner of Section
990 Ft West from Southeast Corner of Section
(Note: Locate well in section plat below)

Lease Name Bergquist Well # 2-32

Field Name Stockholm

Producing Formation Morrow

Elevation: Ground 3883 KB 3893

Section Plat

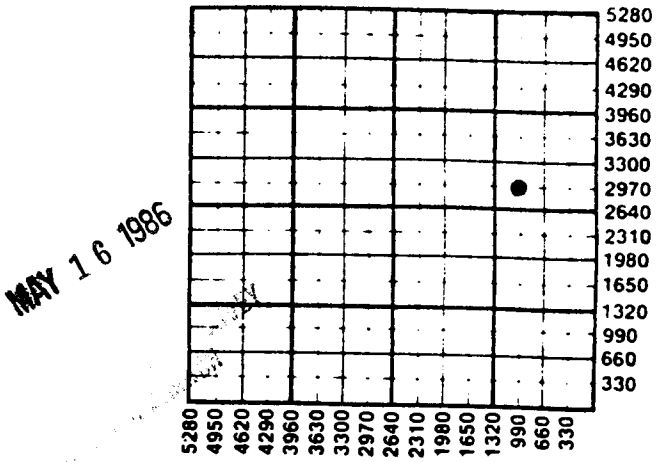

MAY 16 1986

WATER SUPPLY INFORMATION

Disposition of Produced Water: [ ] Disposal
Docket # [ ] Repressuring

Questions on this portion of the ACO-1 call:
Water Resources Board (913) 296-3717

Source of Water:
Division of Water Resources Permit #

[ ] Groundwater Ft North from Southeast Corner
(Well) Ft West from Southeast Corner of
Sec Twp Rge [ ] East [ ] West

[ ] Surface Water Ft North from Southeast Corner
(Stream, pond etc) Ft West from Southeast Corner
Sec Twp Rge [ ] East [ ] West

[X] Other (explain) D. Bergquist, Box 25, Westkan, KS
(purchased from city, R.W.D. #)

INSTRUCTIONS: This form shall be completed in duplicate and filed with the Kansas Corporation Commission, 200 Colorado Derby Building, Wichita, Kansas 67202, within 90 days after completion or recompletion of any well. Rule 82-3-130 and 82-3-107 apply.
Information on side two of this form will be held confidential for a period of 12 months if requested in writing and submitted with the form. See rule 82-3-107 for confidentiality in excess of 12 months.
One copy of all wireline logs and drillers time log shall be attached with this form. Submit CP-4 form with all plugged wells. Submit CP-111 form with all temporarily abandoned wells.