

PLAT AND CERTIFICATION OF ACREAGE ATTRIBUTABLE TO AN OIL WELL

State Corporation Commission, Conservation Division
 200 Colorado Derby Bldg. Wichita, Kansas 67202

OPERATOR Trans-Western Operating Co.

LOCATION OF WELL: NW NW NE

LEASE Bergquist

2,310 feet from the E line

WELL NUMBER 4

330 feet from the N line
 Of the NE of Sec 32 T. 5S R. 42W

FIELD SW Stockholm



COUNTY Wallace

*NUMBER OF ACRES
 ATTRIBUTABLE TO WELL 40

DESCRIPTION OF ACREAGE:

PLAT

(Show location of Well and outline attributable acreage)
 (Show footage to nearest lease or unit boundry line)

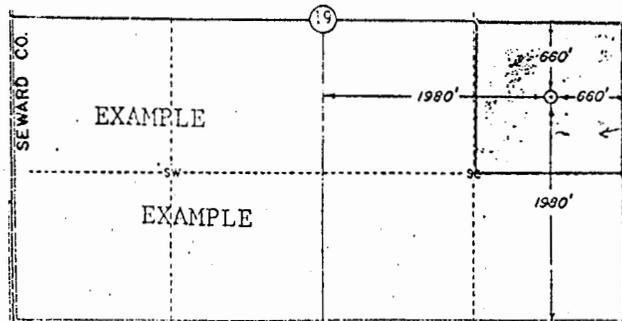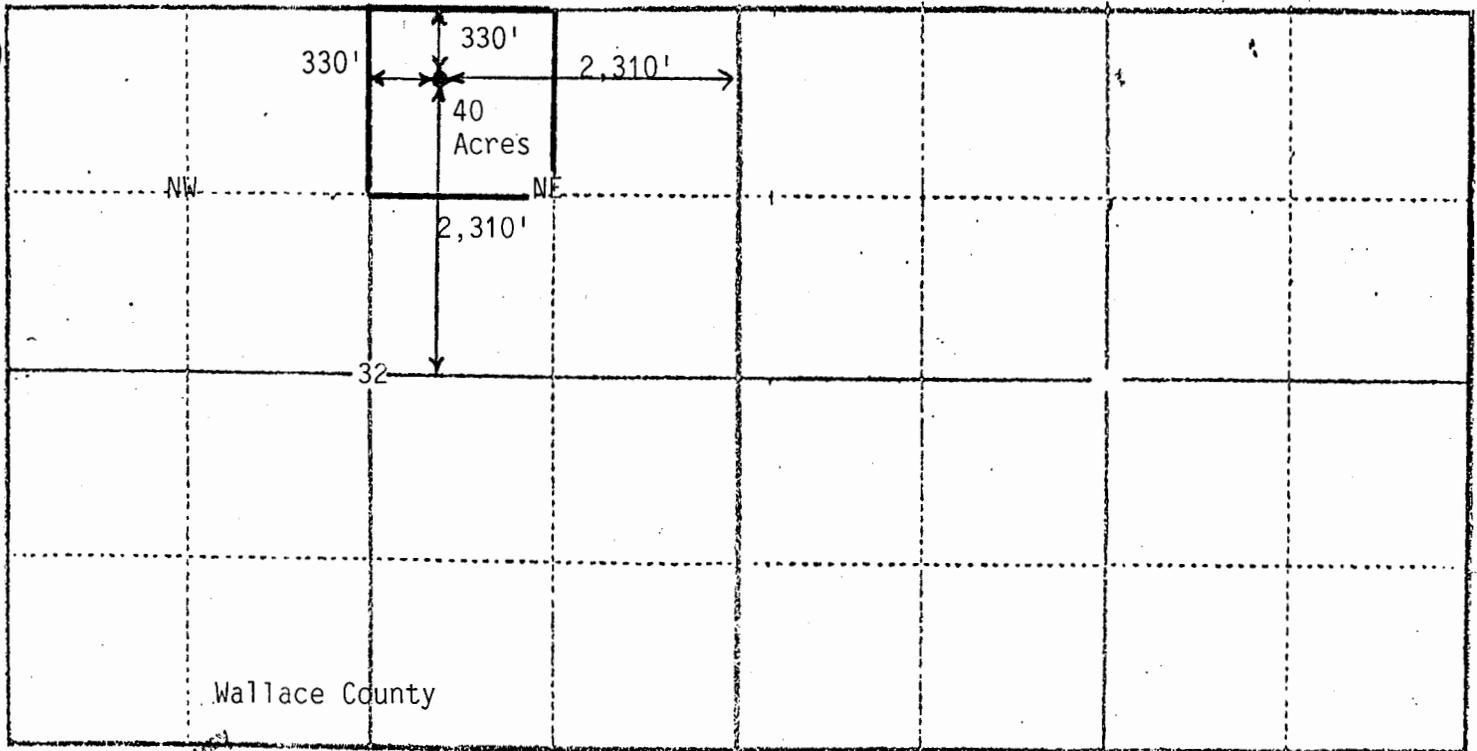

MINERAL SURVEY
 BY JOHN H. HANCOCK

NOV 19 1987

The undersigned hereby certifies that he is Consultant
 for Trans-Western Operating Co., a duly authorized agent, that all information