


Map No. **KANSAS** Sec. 20 Twp. 15 R. 5W
 Well No. 44 1 Laurelengayer
Thompson & Co. Company
 Contractor

SECTION PLAT

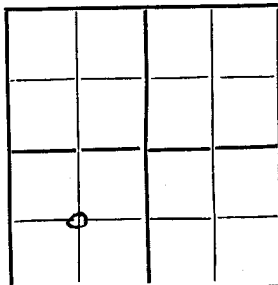

Ft. from N. Line

1320 Ft. from S. Line

Ft. from E. Line

1320 Ft. from W. Line

FIRST REPORTS

Location.....
 Rig up.....
 Drilling and Remarks:

RDG

RECORD

Cased.....in.,ft.
 Sand.....
 Gas.....
 Oil.....
 Total Depth.....

PRODUCTION


1st 24 hrs. Nat.....
 1st 24 hrs. after shot.....
 Gas.....Cu. Ft.
 Dry Hole.....
 Abandoned.....

Date

JUN 19 1929192S. J. LEWIS Scout

Map No. **KANSAS** Sec. 20 Twp. 15 R. 5W
 Well No. 44 1 Laurelengayer
Thompson & Co. Company
 Contractor

SECTION PLAT

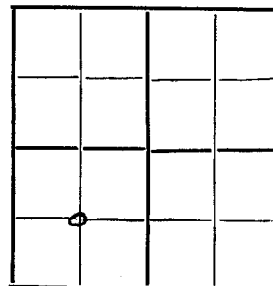

Ft. from N. Line

1320 Ft. from S. Line

Ft. from E. Line

1320 Ft. from W. LineABANDONED

Location.....
 Rig up.....
 Drilling and Remarks:

RECORD

Cased.....in.,ft.
 Sand.....
 Gas.....
 Oil.....
 Total Depth 3812

PRODUCTION


1st 24 hrs. Nat.....
 1st 24 hrs. after shot.....
 Gas.....Cu. Ft.
 Dry Hole.....
 Abandoned.....

Date

JUN 29 1930192S. J. LEWIS Scout

Map No KANSAS Sec. 20 Twp. 15 R. 5^w
Well No 1- Lauderdale Farm
Templemen Oil Company

_____ Ft. from N. Line
1320 Ft. from S. Line
_____ Ft. from E. Line
1320 Ft. from W. Line

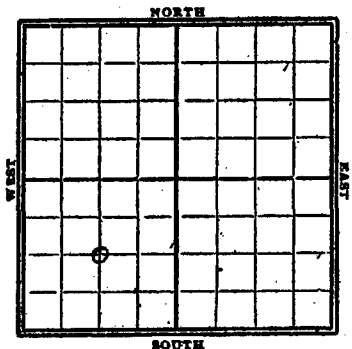

1929

Date	REPORT
6/19	Pool
6/19	—
6/26	Rig
7/2	Rig up
7/10	Orly 500'
7/17	" 1050'
7/24	" 1425'
7/31	S.D. 1750'
8/7	Orly 2265'
8/14	" 2535'
8-21	H2K 2675-2710. Orly 2720
8/28	Orly 2805
9/4	8" 2917 Orly 2945
9/11	Swedge 8"-2955
9/18	—
9/25	—
10/2	—
10/9	—
10/16	—
10/23	Orly 2975' 6"-2970'
10/30	—
11/6	—

11/13 - 2 of chat 3251 HFW
U.R. 6"-3268
11/20 - U.R. 6"-3268'
11/27 - HFW 3275 Orly 3290
12/4 - Orly 3440
12/11 - " 3565'
12/18 - " 3590'
12/23 - " 3655'
12/30 - " 3725'
1930
1/8 - S.D. 3805'
1/15 —
1/22 —
1/29 - T.D. 3812'
Dry & Abandon


Form 51-5M-9-28-27423

Map No. KANSAS Sec. 20 Twp. 15 R. 5 W

Well No. 1 Sandwayer Farm

Templeman Leffal Company

NORTH

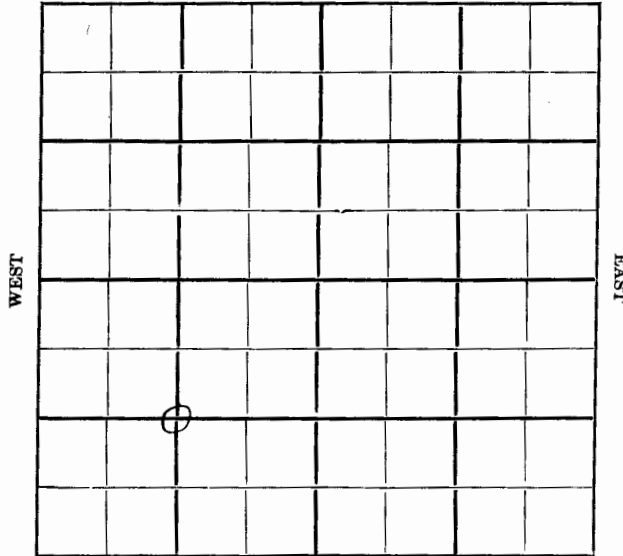

SOUTH

Location.....

Drilling Remarks

.....

.....

Rig Up.....

Drilling Remarks

.....

.....

RECORD

Cased..... in..... ft.

Sand.....

Gas.....

Oil.....

Total Depth.....

PRODUCTION

1st 24 hrs. Nat.....

1st 24 hrs. after shot.....

Gas..... cu. ft.....

Dry Hole.....

Abandoned.....