


KANSAS
 Map No. 2 Sec. 7 Twp. 15 R. 8W

Well No. 1 Urbank

Phillips Company
FIRST REPORT Contractor

SW SE

SECTION PLAT

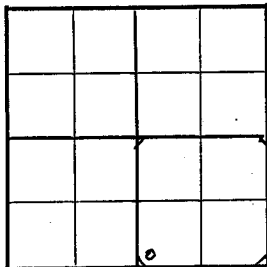

Ft. from N. Line
330
 Ft. from S. Line
 Ft. from E. Line
330 Ft. from W. Line

Wildcat

Location X

Rig up

Drilling and Remarks:

RECORD

Cased _____ in., _____ ft.
 Sand _____
 Gas _____
 Oil _____
 Total Depth _____

PRODUCTION

1st 24 hrs. Nat. _____
 1st 24 hrs. after shot _____
 Gas _____ Cu. Ft.
 Dry Hole _____
 Abandoned _____

Date

JAN 26 1944 19 S. J. LEWIS Scout


KANSAS
 Map No. 7 Sec. 7 Twp. 15 R. 8W

Well No. 1 Urbank

Phillips Company
ABANDONED Contractor

SW SE

SECTION PLAT

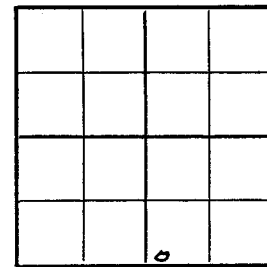

Ft. from N. Line
330
 Ft. from S. Line
 Ft. from E. Line
330 Ft. from W. Line

Wildcat

Location _____

Rig up

Drilling and Remarks:

Lease 2645
See 8/3/69

RECORD

Cased _____ in., _____ ft.
 Sand _____
 Gas _____
 Oil _____
 Total Depth 3212

PRODUCTION

1st 24 hrs. Nat. _____
 1st 24 hrs. after shot _____
 Gas _____ Cu. Ft.
 Dry Hole _____
 Abandoned _____

Date

FEB 23 1944 19 S. J. LEWIS Scout

Ellsworth

Sec. 7 Twp. 15 R. 8-W

Well No. #1 Urbank Farm

Phillips Company


 Ft. from N. Line

330 Ft. from S. Line

 Ft. from E. Line

330 Ft. from W. Line

elev. 1608

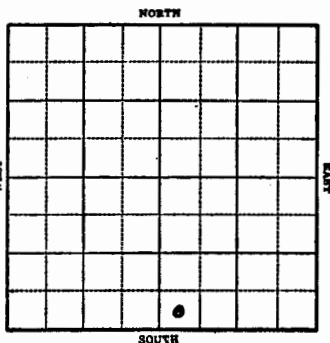

1944 REPORT

1-26 Location

2/2 "

2/8 Drlg. 360

2/15 Anhy 525
8" @ 529
Drlg. 2486

2/23 Lans 2645
Arb 3169
TD 3212

ABANDONED

KANSAS
GAS & PETROL

Ellsworth

Section 7 Township 15 Range 8W

Well No. #1 Urbank

Company Phillips

