


Map No. 45 Sec. 16 Twp. 15 R. 8WWell No. 1 KumbleEmpire Company

Contractor

SECTION PLAT

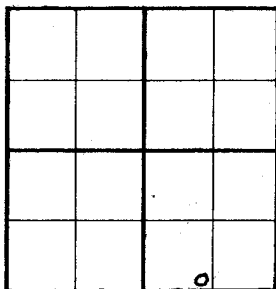

_____ Ft. from N. Line

320 Ft. from S. Line

_____ Ft. from E. Line

990 Ft. from W. Line

FIRST REPORT

Location _____

Rig up _____

Drilling and Remarks:

12 1/2" @ 300WOC

RECORD

Cased _____ in., _____ ft.

Sand _____

Gas _____

Oil _____

Total Depth _____

PRODUCTION

1st 24 hrs. Nat. _____

1st 24 hrs. after shot _____

Gas _____ Cu. Ft.

Dry Hole _____

Abandoned _____


Date

SEP 2 1936 19 S. J. LEWIS Scout

Map No. 45 Sec. 16 Twp. 15 R. 8WWell No. 1 KumbleEmpire Company

Contractor

SECTION PLAT

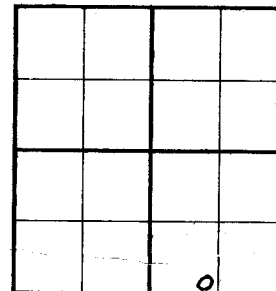

_____ Ft. from N. Line

320 Ft. from S. Line

_____ Ft. from E. Line

990 Ft. from W. Line

ABANDONED

Location _____

Rig up _____

Drilling and Remarks:

Sil 3019HPWJ & A

RECORD

Cased _____ in., _____ ft.

Sand _____

Gas _____

Oil _____

Total Depth 3035

PRODUCTION

1st 24 hrs. Nat. _____

1st 24 hrs. after shot _____

Gas _____ Cu. Ft.

Dry Hole _____

Abandoned _____

Date

SEP 23 1936 19 S. J. LEWIS Scout


KANSAS

Ellsworth

Sec. 16 Twp. 15 R. 8WWell No. #1 Kunkle Farm

Empire

Company

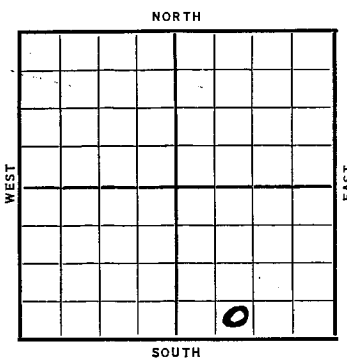

Ft. from N. Line

330'

Ft. from S. Line

Ft. from E. Line

990'

Ft. from W. Line

Elev. 1577

REPORT

1936

9/2

12 1/2" @ 300'. Waiting on omt.

9/23/36-Sil. 3019'.

T. @. 3035'.

Hole full of water.

Dry and abandoned.

ABANDONED

KANSAS

Ellsworth

Section 16 Township 15 Range 8-WWell Number #1-KunkleCompany Empire