

Map No. 45 Sec. 29 Twp. 15 R. 8WWell No. 1 State _____

Ingling & Parker Company

~~FIRST REPORT~~ Contractor

C SW SW

_____ Ft. from N. Line

660 Ft. from S. Line

_____ Ft. from E. Line

660 Ft. from W. Line

WILDCAT

SECTION PLAT

Location _____

Rig up _____

Drilling and Remarks:

Rotary

RECORD

Cased _____ in., _____ ft.

Sand _____

Gas _____

Oil _____

Total Depth _____

PRODUCTION

1st 24 hrs. Nat. _____

1st 24 hrs. after shot _____

Gas _____ Cu. Ft.

Dry Hole _____

Abandoned _____

Date

MAY 14 1941₁₉ S. J. LEWIS ScoutMap No. 45 Sec. 29 Twp. 15 R. 8WWell No. 1 State _____

Ingling & Parker Company

~~COMPLETED~~ Contractor

C SW SW

_____ Ft. from N. Line

660 Ft. from S. Line

_____ Ft. from E. Line

660 Ft. from W. Line

WILDCAT

SECTION PLAT

Location _____

Rig up _____

Drilling and Remarks:

Topeka 2194

4" @ 2555

33 Sp. to 2475-94

10000 Acid

2,176,000 Gas

RECORD

Cased _____ in., _____ ft.

Sand _____

Gas _____

Oil _____

Total Depth 2555

PRODUCTION

1st 24 hrs. Nat. _____

1st 24 hrs. after shot _____

Gas _____ Cu. Ft.

Dry Hole _____

Abandoned _____

Date

JUN 4 1941₁₉ S. J. LEWIS Scout

KANSAS

Ellsworth

Sec. 29 Twp. 15 R. 8-WWell No. #1 State FarmIngling & Parker Company
(Wildcat)


Ft. from N. Line

66.0 Ft. from S. Line

Ft. from E. Line

66.0 Ft. from W. Line

Elev. 1614

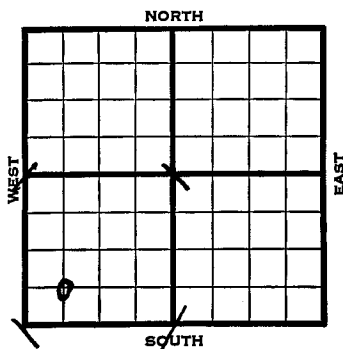

REPORT

19415/14 Rotary.5/22 8" - 84' Drlg. 1874'5/28 Topeka 2194' T.D. 2555'

4" - 2555' RUST. Gas.

6/4 Topeka 2194'

4" - 2555'

T.D. 2555'

33 shots 2475-94'

10,000 acid.

2,176,000 gas.

COMPLETED

KANSAS

Ellsworth

Section 29 Township 15 Range 8-WWell No. 1 StateCompany Ingling & Parker

Wildcat

