

KANSASPool Name WildcatMap No. 45 Sec. 31 Twp. 15 R. 8WWell No. 1 Sauberli "A" (#1 Strat)

Bridgeport _____ Company _____

FIRST REPORT

Contractor _____

NE SW SW

ABANDONED SECTION PLAT

Ft. from N. Line

990

Ft. from S. Line

Ft. from E. Line

990

Ft. from W. Line

Willsworth

Location _____

Rig up _____

Drilling and Remarks:

Hollenberg 1090

Herrington 1140

Winfield 1190

Ft. Riley 1255

Flo 1380

Wreford 1450

Howard 2265

Topeka 2309

Heebner 2567

RECORD

Cased _____ in., _____ ft.

Sand _____

Gas _____

Oil _____

Total Depth 3257**PRODUCTION**

1st 24 hrs. Nat. _____

1st 24 hrs. after shot _____

Gas _____ Cu. Ft.

Dry Hole _____

Abandoned _____

over

Date

MAY 24 1944

19

S. J. LEWIS

Scout

Toronto 2582
 B Oread 2597
 Lans. 2715
 B KC 3011
 Cong. 3055
 Arb. 3072
 TD 3253

D & A

Ellsworth

KANSAS

Sec. 31 Twp. 15 R. 8W

Well No. #1 Sauberli "A" (#1 Strat) Farm

Bridgeport. Company


Wildcat

Ft. from N. Line

990 Ft. from S. Line

Ft. from E. Line

990 Ft. from W. Line

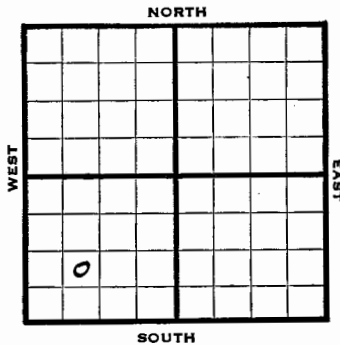

1944

REPORT

5/24

Hollenberg 1090
Herrington 1140
Winfield 1190
Ft. Riley 1255
Flo 1380
Wreford 1450
Howard 2265
Topeka 2309
Heebner 2567
Toronto 2582
B. Oread 2597
Land. 2715
B KC 3011
Cong. 3055
Abr. 3072
TD 3253

FIRST REPORT
and
ABANDONED

KANSAS

Ellsworth

Section 31 Township 15 Range 8W

Well No. #1, Sauberli "A" (#1 Strat)

Company Bridgeport

