


STATE OF KANSAS
STATE CORPORATION COMMISSION

Give All Information Completely
Make Required Affidavit
Mail or Deliver Report to:
Conservation Division
State Corporation Commission
212 North Market, Insurance Bldg.
Wichita, Kansas

WELL PLUGGING RECORD

RECEIVED JAN 16 1975

NORTH

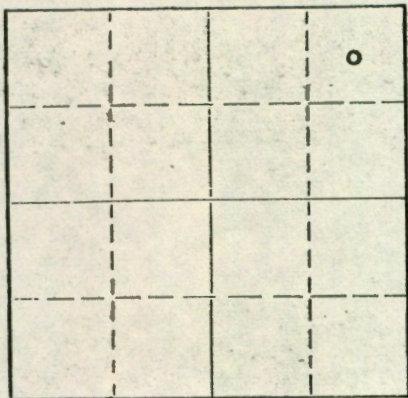

Locate well correctly on above Section Plat

Ellsworth County. Sec. 31 Twp. 15 S Rge. 8 (E) 8 (W)
Location as "NE/CNW/SW" or footage from lines App. NE/4 NE/4
Lease Owner Messman-Rinehart Oil Company
Lease Name Jelinek Well No. 1
Office Address 518 Petroleum Building, Wichita, Kansas
Character of Well (completed as Oil, Gas or Dry Hole) Dry
Date well completed November 12 1960
Application for plugging filed November 12 1960
Application for plugging approved November 12 1960
Plugging commenced November 12 1960
Plugging completed November 12 1960
Reason for abandonment of well or producing formation Dry

If a producing well is abandoned, date of last production 19
Was permission obtained from the Conservation Division or its agents before plugging was commenced? yes

Name of Conservation Agent who supervised plugging of this well Don Truan, Russell, Kansas
Producing formation _____ Depth to top _____ Bottom _____ Total Depth of Well 2661 Feet
Show depth and thickness of all water, oil and gas formations.

OIL, GAS OR WATER RECORDS

CASING RECORD

FORMATION	CONTENT	FROM	TO	SIZE	PUT IN	PULLED OUT
				8-5/8"	240	none

Describe in detail the manner in which the well was plugged, indicating where the mud fluid was placed and the method or methods used in introducing it into the hole. If cement or other plugs were used, state the character of same and depth placed, from _____ feet to _____ feet for each plug set.

Set plug at 230 ft. with 25 sx. cement and 1/4 sk. hulls. Set plug at 40 ft. with 10 sx. cement and 1/4 sk. hulls.

RECEIVED
STATE CORPORATION COMMISSION
DEC 6 1964
CONSERVATION DIVISION
WICHITA, KANSAS

(If additional description is necessary, use BACK of this sheet)

Name of Plugging Contractor Messman-Rinehart Oil Company
Address 518 Petroleum Building, Wichita, Kansas

STATE OF Kansas, COUNTY OF Sedgwick, ss.
J. A. Gilliland (employee of owner) ~~an authorized representative~~ of the above-described well, being first duly sworn on oath, says: That I have knowledge of the facts, statements, and matters herein contained and the log of the above-described well as filed and that the same are true and correct. So help me God.

(Signature) J. A. Gilliland
518 Petroleum Building, Wichita, Kansas
(Address)

SUBSCRIBED AND SWORN TO before me this 5th day of December, 1960
Barbara J. Scott
Barbara J. Scott, Notary Public.

My commission expires December 1, 1964

mailed copy
Red Log in requested
1/17/75
Jone