

Pool Name WildcatMap No. 45 Sec. 23 Twp. 15 R. 9WWell No. 1 Dolecheck "A"

Bridgeport Company

FIRST REPORT Contractor

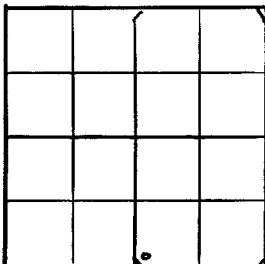
SW SE

SECTION PLAT

Ft. from N. Line

330 Ft. from S. Line

Ft. from E. Line

330 Ft. from W. Line

Ellsworth County

Location X

Rig up

Drilling and Remarks:

RECORD

Cased _____ in., _____ ft.

Sand _____

Gas _____

Oil _____

Total Depth _____

PRODUCTION

1st 24 hrs. Nat. _____

1st 24 hrs. after shot _____

Gas _____ Cu. Ft.

Dry Hole _____

Abandoned _____

Date

MAY 3 1944 19 S. J. LEWIS ScoutPool Name WildcatMap No. 45 Sec. 23 Twp. 15 R. 9WWell No. 1 Dolecheck "A"

Bridgeport Company

ABANDONED Contractor

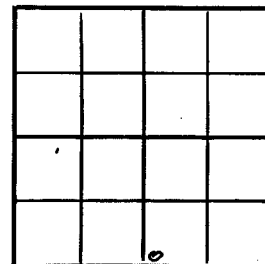
SW SE

SECTION PLAT

Ft. from N. Line

330 Ft. from S. Line

Ft. from E. Line

330 Ft. from W. Line

Ellsworth County

Location _____

Rig up

Drilling and Remarks:

Lease 2677Q.L. 43040

RECORD

Cased _____ in., _____ ft.

Sand _____

Gas _____

Oil _____

Total Depth 3257

PRODUCTION

1st 24 hrs. Nat. _____

1st 24 hrs. after shot _____

Gas _____ Cu. Ft.

Dry Hole _____

Abandoned _____

Date

MAY 24 1944 19 S. J. LEWIS Scout

Ellsworth

Sec. 23 Twp. 15 R. 9W

Well No. #1 Dolecheck "A" Farm

Bridgeport Company

Wildcat

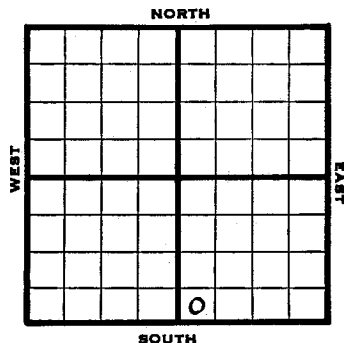
Ft. from N. Line

330 Ft. from S. Line

Ft. from E. Line

330 Ft. from W. Line

Elev. 1611



REPORT

1944

5/3 Location

5/10 "

5/17 8" - 195
Drlg. 2108

5/24 Lans 2677
Arb 3040
TD 3251

ABANDONED

Ellsworth

Section 23 Township 15 Range 9W

Well No. #1 Dolecheck "A"

Company Bridgeport.

