

Map No. _____ Sec. 34 Twp. 15 R. 9WWell No. 1 Barta

Heathman Drlg. _____ Company

Contractor

SW NE NE


SECTION PLAT

990 Ft. from N. Line

Ft. from S. Line

990 Ft. from E. Line

Ft. from W. Line

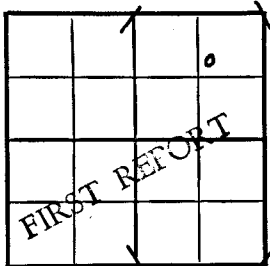

Ellsworth County

Location _____

Rig up _____

Drilling and Remarks:

R U R

RECORD

Cased _____ in., _____ ft.

Sand _____

Gas _____

Oil _____

Total Depth _____

PRODUCTION

1st 24 hrs. Nat. _____

1st 24 hrs. after shot _____

Gas _____ Cu. Ft.

Dry Hole _____

Abandoned _____

Date

FEB 1 1950 19 J. E. TYRA ScoutMap No. _____ Sec. 34 Twp. 15 R. 9WWell No. 1 Barta

Heathman Drlg. _____ Company

Contractor

SW NE NE


SECTION PLAT

990 Ft. from N. Line

Ft. from S. Line

990 Ft. from E. Line

Ft. from W. Line

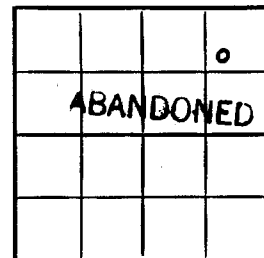

Ellsworth County

Location _____

Rig up _____

Drilling and Remarks:

8" @ 1805 1/2 @ 2742Loss 2724Loss 3390-2741Core 3701D.T.A.

RECORD

Cased _____ in., _____ ft.

Sand _____

Gas _____

Oil _____

Total Depth 3741 ft. long

PRODUCTION

1st 24 hrs. Nat. _____

1st 24 hrs. after shot _____

Gas _____ Cu. Ft.

Dry Hole _____

Abandoned _____

Date

MAR 8 1950 19 J. E. TYRA Scout

KANSAS

Ellsworth

Sec. 34 Twp. 15 R. 9-W ✓

Well No. #1 Barta Farm _____

Heathman Drlg Company _____

Contractor _____

Wildcat


990 Ft. from N. Line

_____ Ft. from S. Line

990 Ft. from E. Line

_____ Ft. from W. Line

SW NE NE

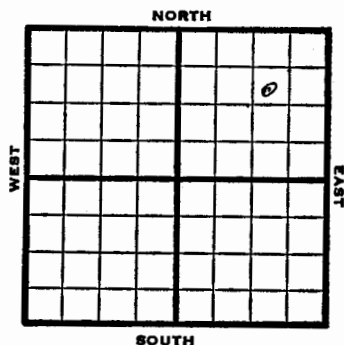

1950 Elev 1651' REPORT

2/1 RUR *Heobner 2586*
3/8 TD 3741' in Cong
8" @ 180'
5 1/2" 2742'
Lans ~~3390~~ *2741-46*
Cong 3701'
D&A
Aband.

ABANDONED

Ellsworth KANSAS

Section 34 Township 15 Range 9W

Well No. #1 Barta

Company Heathman Drlg.

