


2-16-10W

WELL LOG BUREAU—KANSAS GEOLOGICAL SOCIETY
503 East Murdock, Wichita, Kansas

Company. BENNETT & GOULD
Farm. Lank No. 1

SEC. 2 T. 16 R. 10W
SW SW SW

County Ellsworth
KANSAS

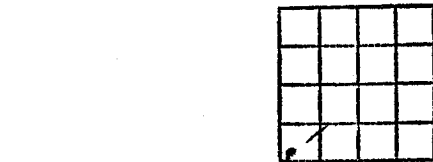

Elevation. 1787' KB

Production. Dry

Total Depth 3386'
Comm. 5-5-55 Comp. 5-15-55
Shot or Treated.
Contractor. Salina Drlg. Corp. Inc.
Issued. 3-30-57

Casing:
8 5/8" 297' w/150 sx cem.

Figures indicate Bottom of Formations.

shale	60
lime	100
red bed-sand	295
shale-sand	460
shale-red bed	560
lime	600
shale-red bed	946
shale-lime	1750
lime	1820
shale-shells	1900
shale-lime	2105
lime-shale	2550
lime-shale-chert	2615
lime	3200
lime-conglomerate	3275
lime	3320
lime-shale-sand	3350
shale-sand	3367
shale	3376
Arbuckle lime	3386
Total Depth	

TOPS:	
Heebner	2808
Toronto	2826
Douglas	2838
Brown lime	2911
Lansing	2926
B/Kansas City(scout)	3205
Conglomerate	3253
Viola	3279
Simpson	3317
Arbuckle	3376