

STATE CORPORATION COMMISSION OF KANSAS
OIL & GAS CONSERVATION DIVISION

WELL COMPLETION OR RECOMPLETION FORM
ACO-1 WELL HISTORY

DESCRIPTION OF WELL AND LEASE

Operator: license # 6901
name D. S. & W. WELL SERVICING, INC.
address P.O. BOX 231
City/State/Zip CLAFLIN, KANSAS 67525

Operator Contact Person ROBERT L. STRUBE
Phone 316-587-3361

Contractor: license # 5929
name DUKE DRILLING COMPANY, INC.

Site Geologist JIM MUSGROVE
Phone 316-792-1383

Designate Type of Completion

- New Well Re-Entry Workover
- Oil SWD Temp Abd
- Gas (M) Delayed Comp.
- Dry Other (Core, Water Supply etc.)

WO: old well info as follows:

Operator
Well Name
Comp. Date Old Total Depth

WELL HISTORY

Drilling Method: Mud Rotary Air Rotary Cable

Start Date 02-84 Date Reached TD 09-20-84 Completion Date 09-25-84

Total Depth 3356' RPTD

Amount of Surface Pipe Set and Cemented at 542' feet

Multiple Stage Cementing Collar Used? Yes No

If Yes, Show Depth Set feet

Alternate 2 completion, cement circulated from feet depth to SURFACE w/ SX cmt

API NO. 15 - 053-20 912

County ELLSWORTH

NE/4 (location) Sec 4 Twp 16S Rge 10 East West

3345 Ft North from Southeast Corner of Section
1930 Ft West from Southeast Corner of Section
(Note: locate well in section plat below)


Lease Name HEITSCHMIDT Well# 12

Field Name PROGRESS NORTH WEST

Producing Formation ARBUCKLE

Elevation: Ground 1761 KB 1768

Section Plat

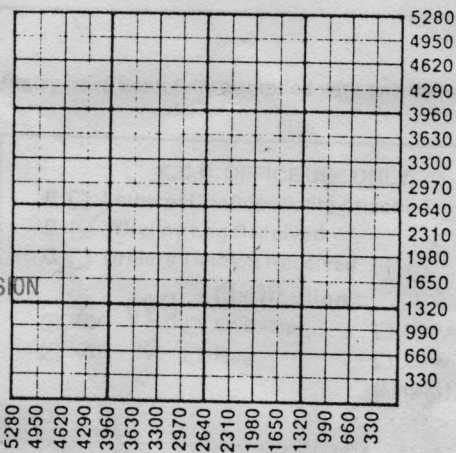

RECEIVED
STATE CORPORATION COMMISSION
NOV 07 1984
CONSERVATION DIVISION
Wichita, Kansas

WATER SUPPLY INFORMATION

Source of Water:

Division of Water Resources Permit #

Groundwater Ft North From Southeast Corner and (Well) Ft. West From Southeast Corner of Sec Twp Rge East West

Surface Water 2970 Ft North From Southeast Corner and (Stream, Pond etc.) 1320 Ft West From Southeast Corner Sec Twp Rge East West

Other (explain) (purchased from city, R.W.D.#)

Disposition of Produced Water: Disposal Repressuring

Docket # 52 588-c (C-5071)

GRANT OIL COMPANY

INSTRUCTIONS: This form shall be completed in duplicate and filed with the Kansas Corporation Commission, 200 Colorado Derby Building, Wichita, Kansas 67202, within 90 days after completion or recompletion of any well. Rules 82-3-130 and 82-3-107 apply.

Information on side two of this form will be held confidential for a period of 12 months if requested in writing and submitted with the form. See rule 82-3-107 for confidentiality in excess of 12 months.

One copy of all wireline logs and drillers time log shall be attached with this form. Submit CP-4 form with all plugged wells. Submit CP-111 form with temporarily abandoned wells.