

KANSAS DRILLERS LOG

State Geological Survey

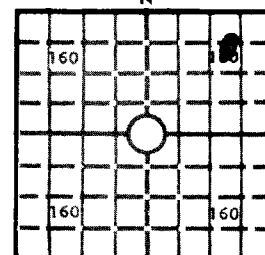
WICHITA BRANCH

API No. 15 — 053 — 20,457
County Number

S. 5 T. 16 R. 10 W

Loc. 780' FNL & 480' FEL NE N

County Ellsworth

640 Acres
N

Elev.: Gr. 1814

DF 1816 KB 1819

Operator

John Jay Darrah, Jr.

Address

1010 Century Plaza Building Wichita, Kansas 67202

Well No.

#5

Lease Name

Vacek

Footage Location

780 feet from (N) (S) line 140 feet from (E) (W) line NE/4

Principal Contractor

Red Tiger Drilling

Geologist

Gerald D. Honas

Spud Date

Dec 1, 1976

Total Depth

3310

P.B.T.D.

Date Completed

December 11, 1976

Oil Purchaser

CASING RECORD

Report of all strings set — surface, intermediate, production, etc.

Purpose of string	Size hole drilled	Size casing set (in O.D.)	Weight lbs/ft.	Setting depth	Type cement	Sacks	Type and percent additives
Surface		10-3/4		325		200	
Production		7'		3297.5		125	

LINER RECORD

Top, ft.	Bottom, ft.	Sacks cement
----------	-------------	--------------

PERFORATION RECORD

Shots per ft.	Size & type	Depth interval
---------------	-------------	----------------

TUBING RECORD

Size	Setting depth	Packer set at
2-7/8"	3310	

ACID, FRACTURE, SHOT, CEMENT SQUEEZE RECORD

Amount and kind of material used	Depth interval treated
None	

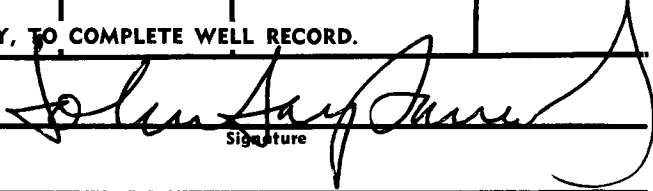
INITIAL PRODUCTION

Date of first production	Producing method (flowing, pumping, gas lift, etc.)				
January 1, 1977					
RATE OF PRODUCTION PER 24 HOURS	Oil	Gas	Water	Gas-oil ratio	
	40 bbls.	MCF	bbls.	CFPB	

Disposition of gas (vented, used on lease or sold)

Producing interval (s)

INSTRUCTIONS: As provided in KCC Rule 82-2-125, within 90 days after completion of a well, one completed copy of this Drillers Log shall be transmitted to the State Geological Survey of Kansas, 4150 Monroe Street, Wichita, Kansas 67209. Copies of this form are available from the Conservation Division, State Corporation Commission, 3830 So. Meridian (P.O. Box 17027), Wichita, Kansas 66217. Phone AC 316-522-2206. If confidential custody is desired, please note Rule 82-2-125. Drillers Logs will be on open file in the Oil and Gas Division, State Geological Survey of Kansas, Lawrence, Kansas 66044.

Operator John Jay Darrah, Jr.		DESIGNATE TYPE OF COMP.: OIL, GAS, DRY HOLE, SWDW, ETC.:		
Well No. #5	Lease Name Vacek		Oil	
S <u>5</u> T <u>16</u> S <u>R</u> <u>E</u> 10W <u>W</u>				
WELL LOG Show all important zones of porosity and contents thereof; cored intervals, and all drill-stem tests, including depth interval tested, cushion used, time tool open, flowing and shut-in pressures, and recoveries.			SHOW GEOLOGICAL MARKERS, LOGS RUN, OR OTHER DESCRIPTIVE INFORMATION.	
FORMATION DESCRIPTION, CONTENTS, ETC.	TOP	BOTTOM	NAME	DEPTH
USE ADDITIONAL SHEETS, IF NECESSARY, TO COMPLETE WELL RECORD.				
Date Received	 _____ Signature _____ Title _____ Date			

922415