

✓
*

Sec. 26 Twp. 16 R. 10-W

Section 26 Township 16 Range 10-W

Well No. #7 Schroeder Farm

Well No. #7 Schroeder

Magnolia Company

Company Magnolia

Stoltenberg Pool

Ft. from N. Line

1320



Ft. from S. Line

Ft. from E. Line

330

Ft. from W. Line

C W L SW

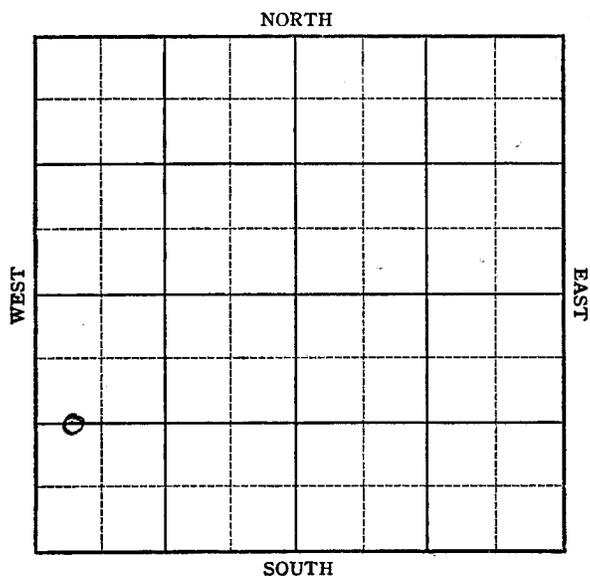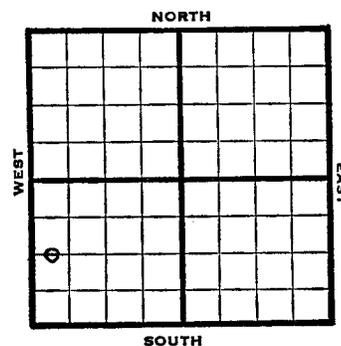

1947

Elev. 1839' REPORT

7/1 Drlg 800'

7/8 8" @ 272'
Drlg 3200'

7-16 Arbuckle 3298
TD 3300
5" @ 3298 swb 12 bbls oil PH-
9hrs.

7/22 Drlg 3302'
SW

7/29 TD 3306' HFW

8/6 Pump 180 water / 2 oil in 12 hrs.

8/13 "

8/20 "

8/27 12 shots 3294-98
Pump 10 bbls oil & 206 W
24 hrs.

OVER

1947

9/3

Arb. 3298'

5" @ 3298'

Pump 9 oil / 207 W pot.

42.0 Gr.

TD 3306'

COMPLETED

Map No. 55 Sec. 26 Twp. 16 R. 10W

Well No. 7 Schroeder


Magnolia Company

CORRECTION Contractor

C W L SW

SECTION PLAT

 Ft. from N. Line
1320 Ft. from S. Line
 Ft. from E. Line
330 Ft. from W. Line

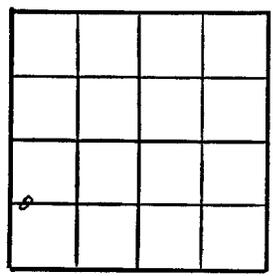

Ellsworth County

Location

RECORD

Cased in., ft.
Sand
Gas
Oil
Total Depth

PRODUCTION

1st 24 hrs. Nat.
1st 24 hrs. after shot
Gas Cu. Ft.
Dry Hole
Abandoned

Reported
C W L Sec.

Date 2 1947 19 S. J. LEWIS Scout

Map No. 55 Sec. 26 Twp. 16 R. 10W

Well No. 7 Schroeder


Magnolia Company

COMPLETE Contractor

C W L SW

SECTION PLAT

 Ft. from N. Line
1320 Ft. from S. Line
 Ft. from E. Line
330 Ft. from W. Line

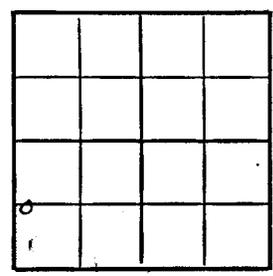

Ellsworth County

Location

RECORD

Cased in., ft.
Sand
Gas
Oil
Total Depth 3206

PRODUCTION

1st 24 hrs. Nat.
1st 24 hrs. after shot
Gas Cu. Ft.
Dry Hole
Abandoned

Core 3298
5' @ 3298
Shut 90' + 207' W
RD
12 2/34

Date SEP 3 1947 19 S. J. LEWIS Scout

Map No. Sec. 26 Twp. 16 R. 10W

Well No. 7 Schroeder


Magnolia Company

TEST REPORT Contractor

C W L Sec.

SECTION PLAT

2640 Ft. from N. Line
 Ft. from S. Line
 Ft. from E. Line
330 Ft. from W. Line

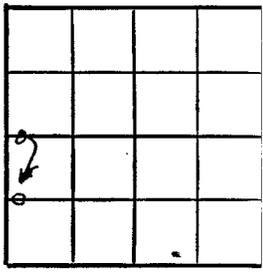

Ellsworth County

Location

RECORD

Cased in., ft.
Sand
Gas
Oil
Total Depth


PRODUCTION

1st 24 hrs. Nat.
1st 24 hrs. after shot
Gas Cu. Ft.
Dry Hole
Abandoned


Drilling and Remarks:
drlg. 800'

Date JUL 2 1947 19 S. J. LEWIS Scout