SIDE ONE

STATE CORPORATION COMMISSION OF KANSAS
OIL & GAS CONSERVATION DIVISION
RECOMPLETION FORM
ACO-2 AMENDMENT TO WELL HISTORY

Operator: License # 6412
Name Sid Tomlinson
Address Rt. 4, Box 7695
Twin Falls, Idaho
City/State/Zip 83301

Purchaser Clear Creek

Operator Contact Person Sid Tomlinson
Phone (208) 734-9329

Designate Type of Original Completion
X New Well ___ Re-Entry ___ Workover

X Oil ___ SWD ___ Temp Abd
___ Gas ___ Inj ___ Delayed Comp.
___ Dry ___ Other (Core, Water Supply etc.)

Date of Original Completion: 2-1-1973

DATE OF RECOMPLETION:

8-31-88 Commenced 9-2-88 Completed

Designate Type of Recompletion/Workover:

___ Deepening ___ Delayed Completion

X Plug Back X Re-perforation

___ Conversion to Injection/Disposal

Is recompleted production:

___ Commingled; Docket No. ___

___ Dual Completion; Docket No. ___

X Other (Disposal or Injection)?

DRYHOLE

API NO. 15- 009-20,719

County Barton

W/2 SW SE Sec 27 Twp 16 Rge 11 X East West

660 Ft North from Southeast Corner of Section
2310 Ft West from Southeast Corner of Section
(Note: Locate well in section plat below)


Lease Name Burmeister Well # 1

Field Name Kraft-Prusa

Name of New Formation Arbuckle

Elevation: Ground 1932 KB 1937

Section Plat

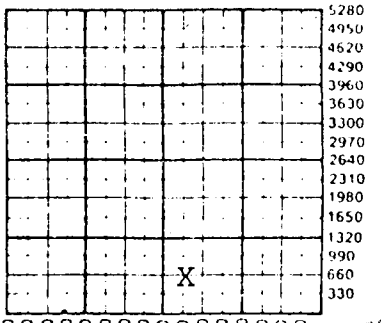

RECEIVED
STATE CORPORATION COMMISSION
SEP 13 1988
CONSERVATION DIVISION
Wichita, Kansas

SEP 13 1988
KANSAS GEOLOGICAL SURVEY
WICHITA BRANCH

K.C.C. OFFICE USE ONLY
F ___ Letter of Confidentiality Attached
C ___ Wireline Log Received
C ___ Drillers Timelog Received
Distribution
✓ KCC ___ SWD/Rep ___ NGPA
✓ KGS ___ Plug ___ Other (Specify)

INSTRUCTIONS: This form shall be completed in triplicate and filed with the Kansas Corporation Commission, 200 Colorado Derby Building, Wichita, Kansas 67202, within 120 days of the recompletion of any well. Rules 82-3-107 and 82-3-141 apply. Information on side two of this form will be held confidential for a period of 12 months if requested in writing and submitted with the form. See rule 82-3-107 for confidentiality in excess of 12 months. One copy of any additional wireline logs and driller's time logs (not previously submitted) shall be attached with this form. Submit ACO-4 prior to or with this form for approval of commingling or dual completions. Submit CP-4 with all plugged wells. Submit CP-111 with all temporarily abandoned wells. NOTE: Conversion of wells to either disposal or injection must receive approval before use; submit form U-1.

All requirements of the statutes, rules and regulations promulgated to regulate the oil and gas industry have been fully complied with and the statements herein are complete and correct to the best of my knowledge.

Signature Sid Tomlinson Title Owner/Operator Date 9/2/88

Subscribed and sworn to before me this 2nd day of September 19 88

Notary Public Corinne Stafford Date Commission Expires 5-26-94

FORM ACO-2
5/88

SIDE TWO

Operator Name Sid Tomlinson Lease Name Burmeister Well # 1

Sec 27 Twp 16 Rge 11 ___ East X West County Barton

RECOMPLETED FORMATION DESCRIPTION:

X Log ___ Sample

Name	Top	Bottom
Arbuckle - perforated 3382-85 w/10 jets test 1/2 BPH (50% oil) - non-commercial To abandon well		

ADDITIONAL CEMENTING/SQUEEZE RECORD

Purpose:	Depth Top	Depth Bottom	Type of Cement	# Sacks Used	Type & Percent Additives
___ Perforate					
___ Protect Casing					
___ Plug Back TD					
___ Plug Off Zone					

Shots Per Foot	PERFORATION RECORD Specify Footage of Each Interval Perforated	Acid, Fracture, Shot, Cement Squeeze Record (Amount and Kind of Material Used)
3	3382-85	750 Gals of 15% acid

PBTD 3388 Plug Type cast iron bridge plug

TUBING RECORD:

Size N/A Set At ___ Packer At ___ Was Liner Run? ___ Y ___ N

Date of Resumed Production, Disposal or Injection ___.

Estimated Production Per 24 Hours ___ bbl/oil ___ bbl/water

D & A ___ MCF gas ___ gas-oil ratio

RECEIVED
STATE CORPORATION COMMISSION
SEP 19 1988
CONSERVATION DIVISION
Wichita, Kansas