


**KANSAS DRILLERS LOG**

S. 6 T. 16S R. 12 <sup>W</sup><sub>W</sub>

Loc. NW NE NW

County Barton

640 Acres

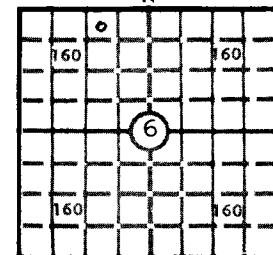

Locate well correctly

Elev.: Gr. 1873

DF 1875 KB 1877

API No. 15 — 009 — 21,173  
County Number

Operator  
Palomino Petroleum

Address  
500 Insurance Bldg., Wichita, Kansas 67202

Well No. #1 Lease Name Miller "G"

Footage Location  
330 feet from (N)  line 990 feet from (E)  line NW/4

Principal Contractor Woodman-Iannitti Drlg. Co. Geologist R. W. Watchous

Spud Date May 12, 1977 Total Depth 3370' P.B.T.D.

Date Completed May 17, 1977 Oil Purchaser None

**CASING RECORD**

Report of all strings set — surface, intermediate, production, etc.

Purpose of string	Size hole drilled	Size casing set (in O.D.)	Weight lbs/ft.	Setting depth	Type cement	Sacks	Type and percent additives
Surface	12 1/4'	8 5/8"	20#	411'	Common	225	2% Gel. 3% c.c.

**LINER RECORD**

**PERFORATION RECORD**

Top, ft.	Bottom, ft.	Sacks cement	Shots per ft.	Size & type	Depth interval

**TUBING RECORD**

Size	Setting depth	Packer set at

**ACID, FRACTURE, SHOT, CEMENT SQUEEZE RECORD**

Amount and kind of material used	Depth interval treated

**INITIAL PRODUCTION**

Date of first production		Producing method (flowing, pumping, gas lift, etc.)			
RATE OF PRODUCTION PER 24 HOURS		Oil	Gas	Water	Gas-oil ratio
		bbis.	MCF	bbis.	CFPB
Disposition of gas (vented, used on lease or sold)				Producing interval (s)	

INSTRUCTIONS: As provided in KCC Rule 82-2-125, within 90 days after completion of a well, one completed copy of this Drillers Log shall be transmitted to the State Geological Survey of Kansas, 4150 Monroe Street, Wichita, Kansas 67209. Copies of this form are available from the Conservation Division, State Corporation Commission, 3830 So. Meridian (P.O. Box 17027), Wichita, Kansas 66217. Phone AC 316-522-2206. If confidential custody is desired, please note Rule 82-2-125. Drillers Logs will be on open file in the Oil and Gas Division, State Geological Survey of Kansas, Lawrence, Kansas 66044.

Operator

Palomino Petroleum

DESIGNATE TYPE OF COMP.: OIL, GAS, DRY HOLE, SWDW, ETC.:

Dry Hole

Well No.

#1

Lease Name

Miller "G"

S 6 T 16S R 12 E W

WELL LOG


Show all important zones of porosity and contents thereof; cored intervals, and all drill-stem tests, including depth interval tested, cushion used, time tool open, flowing and shut-in pressures, and recoveries.

SHOW GEOLOGICAL MARKERS, LOGS RUN, OR OTHER DESCRIPTIVE INFORMATION.

FORMATION DESCRIPTION, CONTENTS, ETC.	TOP	BOTTOM	NAME	DEPTH
Elog Tops:				
Anhydrite	826			
Heebner	2986			
Brown Lime	3071			
Lansing-KC	3080			
Cherty Conglomerate	3357			
Total Depth	3365			

USE ADDITIONAL SHEETS, IF NECESSARY, TO COMPLETE WELL RECORD.

Date Received

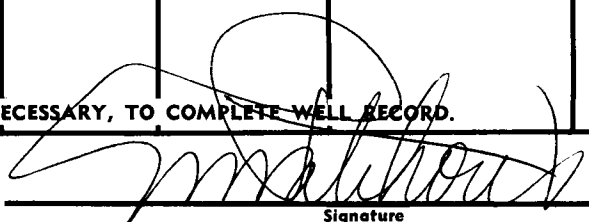

Signature

Owner - Palomino Petroleum

Title

June 7, 1977

Date

665915

K. T. WOODMAN  
RES. PHONE 733-0418  
OFF. PHONE 265-7650  
WICHITA, KANSAS

D. J. IANNITTI  
PHONE 792-2921  
GREAT BEND, KANSAS

WOODMAN & IANNITTI DRILLING COMPANY  
Rotary Drilling Contractors

1008 DOUGLAS BUILDING  
104 S. BROADWAY  
WICHITA, KANSAS 67202

6-16S-12W

RECEIVED

MAY 24 1977

PALOMINO  
PETROLEUM

May 20, 1977

Company;	Palomino Petroleum
Farm;	#1 Miller "G"
Location;	NW NE NW
Section;	6-16S-12W
County;	Barton
Contractor;	Woodman & Iannitti Drilling Co.
Comm;	May 12, 1977
Compl;	May 18, 1977
Total Depth;	3370'
Casing;	8 5/8 @ 411' w/225 sx
Production;	D & A

Figures Indicate Bottom Of Formations:

411	Shale
610	Sand & Shale
826	Shale
854	Anhy
1380	Shale
1580	Shale & Lime
1885	Shale & Lime
2084	Shale
2435	Shale & Lime
2735	Shale & Lime
3092	Lime
3320	Lime
3370	Lime, Shale & Snad

I certify the above to be a true and correct copy of the drillers log to the best of my knowledge and belief.

Woodman & Iannitti Drilling Co.

*K. T. Woodman*  
K. T. Woodman

516577

