

Map No. \_\_\_\_\_ Sec. 1 Twp. 16 R. 14W

Map No. 73 Sec. 1 Twp. 16 R. 14W

Well No. 6 Stettinger

Well No. 6 Stettinger

Shell Company

Shell Company

Contractor

Contractor

FIRST REPORT

SECTION PLAT

COMPLETED

SECTION PLAT

SE SW SE

SE SW SE

\_\_\_\_\_ Ft. from N. Line

\_\_\_\_\_ Ft. from N. Line

330 Ft. from S. Line

330 Ft. from S. Line

\_\_\_\_\_ Ft. from E. Line

\_\_\_\_\_ Ft. from E. Line

990 Ft. from W. Line

990 Ft. from W. Line

			0

			0

Location X

Location \_\_\_\_\_

RECORD

RECORD

Cased \_\_\_\_\_ in., \_\_\_\_\_ ft.

Cased 4 in., 3322 ft.

Sand \_\_\_\_\_

Sand ARB 3321

Gas \_\_\_\_\_

Gas \_\_\_\_\_

Oil \_\_\_\_\_

Oil \_\_\_\_\_

Total Depth \_\_\_\_\_

Total Depth 3343

PRODUCTION

PRODUCTION

1st 24 hrs. Nat. \_\_\_\_\_

1st 24 hrs. Nat. \_\_\_\_\_

1st 24 hrs. after shot \_\_\_\_\_

1st 24 hrs. after shot \_\_\_\_\_

Gas \_\_\_\_\_ Cu. Ft.

Gas \_\_\_\_\_ Cu. Ft.

Dry Hole \_\_\_\_\_

Dry Hole \_\_\_\_\_

Abandoned \_\_\_\_\_

Abandoned \_\_\_\_\_

*2000 acid*

*15 bbls*

*MIN. WELL*

Date


Date

OCT 12 1936 19 H. D. Hatfield Scout


NOV 30 1936 19 H. D. Hatfield Scout

FORM 252-A 5M 1-38 KANSAS Barton  
 Sec. 1 Twp. 16 R. 14-W  
 Well No. #6 Stettinger Farm \_\_\_\_\_  
Shell Company \_\_\_\_\_

\_\_\_\_\_ Ft. from N. Line  
330 Ft. from S. Line  
 \_\_\_\_\_ Ft. from E. Line  
990 Ft. from W. Line  
 Elev. 1908

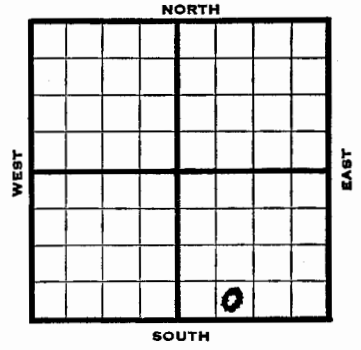

FORM 51 5M 2-38 TPCO. Barton KANSAS  
 Section 1 Township 16 Range 14-W  
 Well No. 6 Stettinger  
 Company Shell

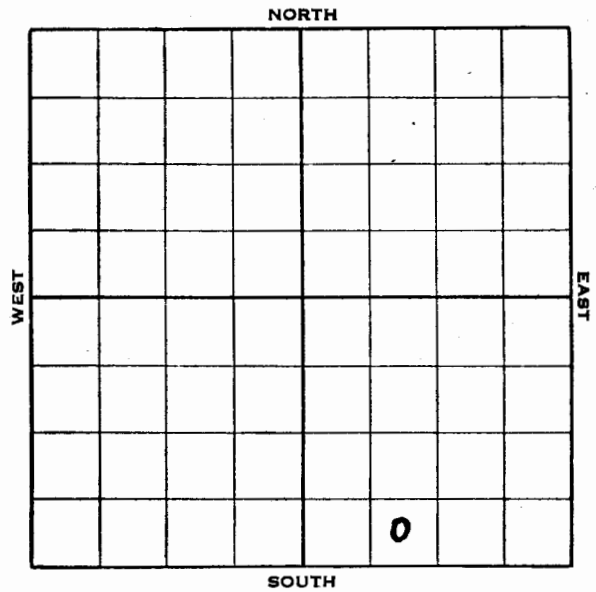

1938	REPORT
10/12	Location
10/21	"
10/28	S. H.
11/4	8" - 668'. Dlg. 1650'.
11/12	Drlg. 2603'.
11/18	Topeka 2797'. Lans. 3108'.
	Arb. 3321-25' T.D. Rng. 4".
11/25	4" - 3322'. Dlg. 3333'.
	2700' oil.
11/30	4" - 3322'.
	Arb. 3321'.
	T. D. 3343'.
	2000 acid.
	15 bbls. Minimum Well.
	COMPLETED