

KANSAS

Barton

Map No. _____ Sec. 1 Twp. 16 R. 14WWell No. 1- StettingerOhio Oil Company

Contractor _____

FIRST REPORT

330 Ft. from N. Line

_____ Ft. from S. Line

_____ Ft. from E. Line

990 Ft. from W. Line

SECTION PLAT

Location ✓

Rig up _____

Drilling and Remarks: _____

RECORD

Cased _____ in., _____ ft.

Sand _____

Gas _____

Oil _____

Total Depth _____

PRODUCTION

1st 24 hrs. Nat. _____

1st 24 hrs. after shot _____

Gas _____ Cu. Ft.

Dry Hole _____

Abandoned _____

Date

SEP 1 1937 19 H. D. Hatfield Scout

Barton

KANSAS

Map No. _____ Sec. 1 Twp. 16 R. 14WWell No. 1 StettingerOhio Company

Contractor _____

COMPLETED

NE NW NE

330 Ft. from N. Line

_____ Ft. from S. Line

_____ Ft. from E. Line

990 Ft. from W. Line

SECTION PLAT

Location _____

Rig up _____

Drilling and Remarks: _____

2000 acidPot-1184

RECORD

Cased 7 in., 3285 ft.Sand 511 3286

Gas _____

Oil _____

Total Depth 3291

PRODUCTION

1st 24 hrs. Nat. _____

1st 24 hrs. after shot _____

Gas _____ Cu. Ft.

Dry Hole 50

Abandoned _____


Date

OCT 13 1937 19 H. D. Hatfield Scout

KANSAS Barton

Sec. 1 Twp. 16 R. 14-WWell No. #1 Stettinger FarmOhio Oil Company330 Ft. from N. Line Ft. from S. Line Ft. from E. Line990 Ft. from W. Line

Elev. 1858

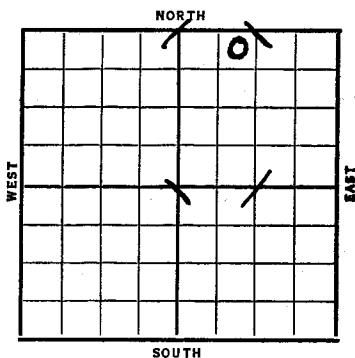

Date REPORT

1937

9/1 Location

9/10 B.R.R.

9/17 Drlg. 585'.

9/24 13" @ 530'. Anhy 845'.

Drlg. 2400'.

10/2 Sil. 3286'. T.D. 3291'.

7" @ 3285'. 2500' oil 1 hr.

10/8 " " " " "

10/13 7" @ 3285'.

Sil. 3286'.

T.D. 3291'.

2000 acid.

Potential 1184 bbls.

COMPLETED

KANSAS

Barton

Section 1 Township 16 Range 14-WWell No. 1 - StettingerCompany Ohio Oil