

Barton

Map No. 73 Sec. 11 Twp. 16 R. 15W

Well No. 1 E Keil

J. A. Brunk & Co. Company

Contractor

SECTION PLAT

			0

_____ Ft. from N. Line

330 Ft. from S. Line

330 Ft. from E. Line

_____ Ft. from W. Line

FIRST REPORT

Location _____

RECORD

Cased _____ in., _____ ft.

Sand _____

Gas _____

Oil _____

Total Depth _____

PRODUCTION

1st 24 hrs. Nat. _____

1st 24 hrs. after shot _____

Gas _____ Cu. Ft.

Dry Hole _____

Abandoned _____

Date

MAY 27 1936

19

S. J. LEWIS

Scout

Barton

KANSAS

Map No. 73 Sec. 11 Twp. 16 R. 15W

Well No. 1 Keil

Brunk & Co. Company

Contractor

SECTION PLAT

			0

_____ Ft. from N. Line

330 Ft. from S. Line

330 Ft. from E. Line

_____ Ft. from W. Line

ABANDONED

Location _____

RECORD

Cased _____ in., _____ ft.

Sand _____

Gas _____

Oil _____

Total Depth 3438

PRODUCTION

1st 24 hrs. Nat. _____

1st 24 hrs. after shot _____

Gas _____ Cu. Ft.

Dry Hole _____

Abandoned _____

Date

SEP 2 1936

19

S. J. LEWIS


Scout

Barton

Map No. **KANSAS** Sec. **11** Twp. **16** R. **15W**

Well No. **#1 E Keil** Farm

J.A. Brouk et al Company

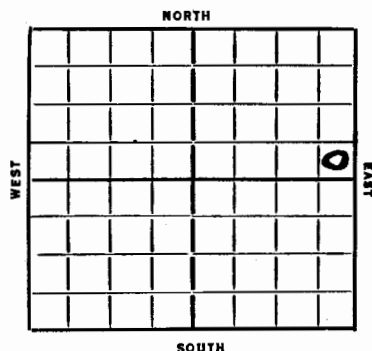

Ft. from N. Line

330' Ft. from S. Line

330' Ft. from E. Line

Ft. from W. Line

Date **1936**

REPORT

5/27 Building rig.

6/4 -- ~~1/11~~

6/11 Spud.

6/18 Drlg. 365'.

6/25 Drlg 1215'.

7/2 Drlg. 2225'.

7/9 8" @ 2565'.

7/16 Topeka 2875'. Drlg. 2940'.

7/23 6" @ 3040'. Drlg. 3065'.

7/30 6" @ 3160'. Drlg. 3280'.

**8/6 Siliceous 3408-3427'. 5 bailers
water 2000' water in 72 hours.**

8/13 Shut down.

8/20--

**8/27 5" @ 3405'. Hole full of water 3425'
to 26'. TD 3438'. Plug back to 3426'
acidized with 1000 gallons. No test**

9/2/36-Sil. 3408'. T.D. 3438'.

**P.B. 3418'. Water. 1000 gal acid
Dry and abandoned.**

ABANDONED

KANSAS

Barton

Form 51-5M-4-36-Palace

Section **11** Township **16** Range **15W**

Well Number **#1 E. Keil**

Company **J. A. Brounk et al**

