

County Barton State Kansas
 Sec. 14 (Blk. 16 (Sur. 15W Map No.
 Operator Nadel & Gussman
 Well No. 1 Farm Karst
 Elev. _____ Location SW SW NW
330 Ft. From S Line NW
330 Ft. From W Line Quarter
 1st. Report SEP 27 1950
 Completion _____
 Remarks Atl. & Carter DFM
Reserve Drlg. - Contractor
 Spudding Date _____
 Drlg. Data Wildcat
Cellar & pits

J. E. TYRA

County Barton State Kansas
 Sec. 14 (Blk. 16 (Sur. 15W Map No.
 Operator Nadel & Gussman
 Well No. 1 Farm Karst
 Elev. 1987 Location SW SW NW
330 Ft. From S Line NW
330 Ft. From W Line Quarter
 1st. Report _____
 Completion OCT 18 1950
 Remarks Wildcat
Reserve Drlg. - Contr.
 Spudding Date 9-30-50
 Drlg. Data D & A TD 3543

8" @ 200 Anhy 1010 Heeb. 3170
Toronto 3190 Lens. 3229 Cong. 3483
Arb. 3502-43 DST 3505-10 open 1 hr.
Rec. 5' mud D & A

J. E. TYRA

Sec. 14 Twp. 16 R. 15-W **KANSAS** **Barton**

Well No. #1 Karst Farm

Nadel & Gussman Company

Reserve Drlg. Contractor


Wildcat

Ft. from N. Line

330 Ft. from S. Line

Ft. from E. Line

330 Ft. from W. Line

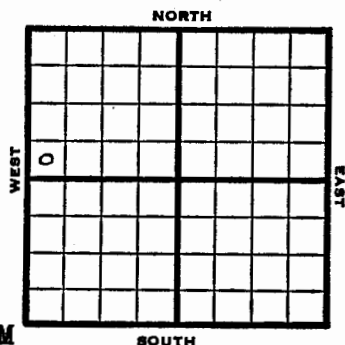

SW SW NW

Atl. & Carter DHM

1950 Elev. 1987' **REPORT**

9/27 **Cellar & Pits**

10/18 Spud 9-30-50
D&A TD 3543'
8" @ 200' Anhy 1010'
Heeb. 3170' Toronto 3190'
Lans. 3229' Cong. 3483'
Arb. 3502-43'
DST 3505-10 opn 1 hr
Rec. 5'mud D&A

ABANDONED

Section 14 Township 16 Range 15W

Well No. #1 Karst

Company Nadel & Gussman

