


Map No. 73 Sec. 25 Twp. 16 R. 15WWell No. 1 MartzFalcon-Seaboard etal. Company**FIRST REPORT**

Contractor

SE NW

SECTION PLAT

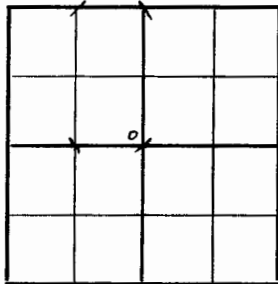

Ft. from N. Line

330 Ft. from S. Line330 Ft. from E. Line

Ft. from W. Line

WILDCAT

Location

Rig up

Drilling and Remarks:

Rotary

RECORD

Cased _____ in., _____ ft.

Sand _____

Gas _____

Oil _____

Total Depth _____

PRODUCTION

1st 24 hrs. Nat. _____

1st 24 hrs. after shot _____

Gas _____ Cu. Ft.

Dry Hole _____

Abandoned _____

Date

MAR 4 1942

19


S. J. LEWIS Scout

Map No. 73 Sec. 25 Twp. 16 R. 15WWell No. 1 MartzFalcon-Seaboard etal. Company**ABANDONED**

Contractor

SE NW

SECTION PLAT

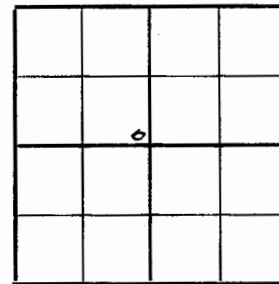

Ft. from N. Line

330 Ft. from S. Line330 Ft. from E. Line

Ft. from W. Line

WILDCAT

Location

Rig up

Drilling and Remarks:

Loss 3249
Comp. 3460
Exp 3509
No shows

RECORD

Cased _____ in., _____ ft.

Sand _____

Gas _____

Oil _____

Total Depth 3540

PRODUCTION

1st 24 hrs. Nat. _____

1st 24 hrs. after shot _____

Gas _____ Cu. Ft.

Dry Hole _____

Abandoned _____

Date

MAR 25 1942

19

S. J. LEWIS Scout

KANSAS

Barton

Sec. 25 Twp. 16 R. 15-W

Well No. #1 Martz Farm _____

Falcon-Seaboard et al Company _____

(Wildcat)


_____ Ft. from N. Line

330 Ft. from S. Line

330 Ft. from E. Line

_____ Ft. from W. Line

Elev. 1976

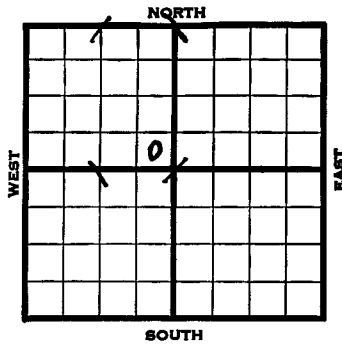

1942

REPORT

3/4

Rotary.

3/12

8" - 72' Drlg. 570'

3/19

Anhy. 978' Drlg. 2665'

3/25

Lans. 3243'

Cong. 3460'

Arb. 3509'

T.D. 3540'

No shows.

ABANDONED

KANSAS

Barton

FORM 51 5M 1-42 PETROL

Section 25 Township 16 Range 15-W

Well No. 1 Martz

Company Falcon-Seaboard et al

