

Map No. _____ Sec. 26 Twp. 16 R. 15WWell No. 1 Seidl

B & R Etal. _____ Company

FIRST REPORT _____ Contractor

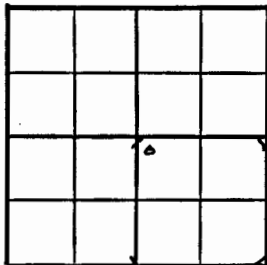
NW SE

SECTION PLAT

330 Ft. from N. Line

_____ Ft. from S. Line

_____ Ft. from E. Line

330 Ft. from W. Line

Barton County

Location _____

Rig up _____

Drilling and Remarks:

8" @ 125

RECORD

Cased _____ in., _____ ft.

Sand _____

Gas _____

Oil _____

Total Depth _____

PRODUCTION

1st 24 hrs. Nat. _____

1st 24 hrs. after shot _____

Gas _____ Cu. Ft.

Dry Hole _____

Abandoned _____

Date

FEB 23 1949 19 _____ S. J. LEWIS Scout

Map No. K-73 Sec. 26 Twp. 16 R. 15WWell No. 1 Seidl

B & R etal. _____ Company

ABANDONED _____ Contractor

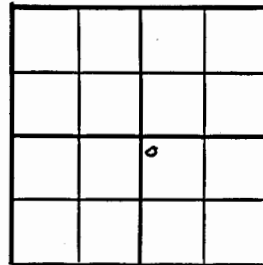
NW SE

SECTION PLAT

330 Ft. from N. Line

_____ Ft. from S. Line

_____ Ft. from E. Line

330 Ft. from W. Line

Barton County

Location _____

Rig up _____

Drilling and Remarks:

Cased

RECORD

Cased _____ in., _____ ft.

Sand _____

Gas _____

Oil _____

Total Depth 950?

PRODUCTION

1st 24 hrs. Nat. _____

1st 24 hrs. after shot _____

Gas _____ Cu. Ft.

Dry Hole _____

Abandoned _____

Date

MAY 4 1949 19 _____ S. J. LEWIS Scout

Barton

Sec. 26 **KANSAS** Twp. 16 R. 15W ✓

Well No. #1 Seidl Farm

B & R et al

Company

Wildcat

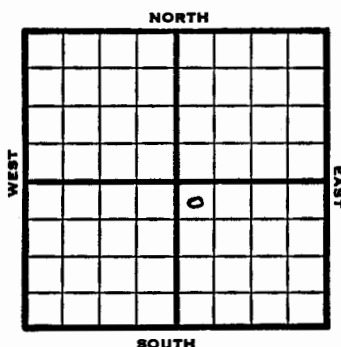
330' Ft. from N. Line

Ft. from S. Line

Ft. from E. Line

330' Ft. from W. Line

NW SE



1949 Elev 1986' REPORT

2/23 8" @ 125'
3/2 Drlg 2695'
3/8 SD
3/16 "
3/23 "
3/30 Lansing 3251
Cong 3494'
Arb. 3506'
Drlg 5516'
4/6 3553' fsg.
4/12 "
4/20 TD 3553'
5" @ 3553'
4/27 24 shots 3503-11
500 acid
5/4 TD 3557'
Arb. 3504'
Aband

ABANDONED

KANSAS

Barton

Section 26 Township 16 Range 15W

Well No. 1 Seidl

Company B & R Et al

Wildcat

