

County Barton State Kansas
 Sec. 27 (Blk. 16 (Sur. 15W Map No.
 Operator N C R A
 Well No. 1 Farm Olivierius
 Elev. Location SE NE SW
 990 Ft. From N Line SW
 330 Ft. From E Line Quarter
 1st. Report MAR 19 1952
 Completion
 Remarks Carter 2500
Braden Drlg. - Contr.
 Spudding Date 3-15-52

Drlg. Data Wildcat

8" @ 370 drlg. 1050

J. G. McGEHEE

County Barton State Kansas
 Sec. 27 (Blk. 16 (Sur. 15W Map No.
 Operator N C R A
 Well No. 1 Farm Olivierius
 Elev. 1999 Location SE NE SW
 990 Ft. From N Line SW
 330 Ft. From E Line Quarter
 1st. Report
 Completion APR 2 1952
 Remarks Wildcat
Braden Drlg. - Contr.
 Spudding Date 3-15-52

Drlg. Data D & A TD 3751

8" @ 370 Heeb. 3220 Lans. 3283

B KC 3510 Cong. 3527 Arb. 3651

TD 3751

D & A

J. G. McGEHEE

Barton KANSAS

Sec. 27 Twp. 16 R. 15W

Well No. #1 Olivierius Farm

NCRA Company

Braden Drlg. - Contr. Contractor

Wildcat


990' Ft. from N. Line

Ft. from S. Line

330' Ft. from E. Line

Ft. from W. Line

SE NE SW

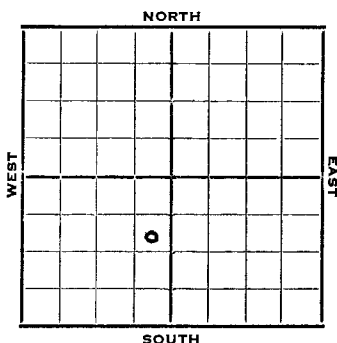

1952 Elev. 1999' REPORT

3/19 8" @ 370
Drlg. 1050'
4/2 Spud 3-15-52
D&A TD 3751
8" @ 370
Heeb. 3220
B KC 3510
Arb. 3651
TD 3751 D&A

Lans. 3283
Cong. 3527

ABANDONED

Barton KANSAS

Section 27 Township 16 Range 15 W

Well No. # 1 Olivierius

Company N C R A

