

Map No. _____ Sec. 31 Twp. 16 R. 15W

Well No. 1-Scheurmann

Wakefield et al Company

Contractor

SECTION PLAT

		0	

330 Ft. from N. Line

_____ Ft. from S. Line

330 Ft. from E. Line

_____ Ft. from W. Line

FIRST REPORT

Location 0 0

Rig up 0

Drilling and Remarks:

Rig

RECORD

Cased _____ in., _____ ft.

Sand _____

Gas _____

Oil _____

Total Depth _____

PRODUCTION

1st 24 hrs. Nat. _____

1st 24 hrs. after shot _____

Gas _____ Cu. Ft.

Dry Hole _____

Abandoned _____

Date

FEB 24 1937 19 S. J. LEWIS Scout

Map No. 73 Sec. 31 Twp. 16 R. 15W

Well No. 1-Scheurmann

Wakefield et al Company

Contractor

SECTION PLAT

		0	

ABANDONED

330 Ft. from N. Line

_____ Ft. from S. Line

330 Ft. from E. Line

_____ Ft. from W. Line

Location _____

Rig up _____

Drilling and Remarks:

D & A

RECORD

Cased _____ in., _____ ft.

Sand 511 3552

Gas _____

Oil _____

Total Depth 3580

PRODUCTION

1st 24 hrs. Nat. _____

1st 24 hrs. after shot _____

Gas _____ Cu. Ft.

Dry Hole _____

Abandoned _____

Date

MAY 26 1937 19 H. D. Hatfield Scout

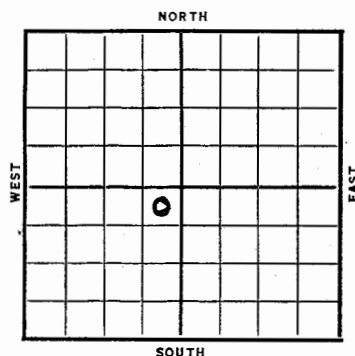
Sec. 31 Twp. 16 R. 15-WWell No. #1 Schenermann FarmWakefield et al Company330 Ft. from N. Line

Ft. from S. Line

330 Ft. from E. Line

Ft. from W. Line

Elev. 1991

**1957** REPORT**2/24** Rig**3/4** 15" @ 445'. Drlg.**3/11** Rig.**3/18** "**3/25** Rigging up**4/2** 12" @ 440', 454 under ream 12"**4/8** Drlg. 760'**4/16** 10" @ 1083'. Drlg. 1090'.**4/23** Drlg. 2340'.**4/30** T.D. 2470' SD.**5/7** Rng. 8" @ 2470'.**5/14** 8" @ 2475'. Drlg. 3070'.**5/21** K.C. 3286'. Drlg. 3510'.**5/26** Sil. 3552'.

T.D. 3580'.

ABANDONEDSection 31 Township 16 Range 15-WWell Number 1 SchenermannCompany Wakefield et al