



Barton

KANSAS  
15W

Sec. 35 Twp. 16 R. 15W

Well No. #1 Martz Farm

H.E. Zoller & Stearns Pet. Company

Stearns Contractor


Wildcat.

330 Ft. from N. Line

Ft. from S. Line

330 Ft. from E. Line

Ft. from W. Line

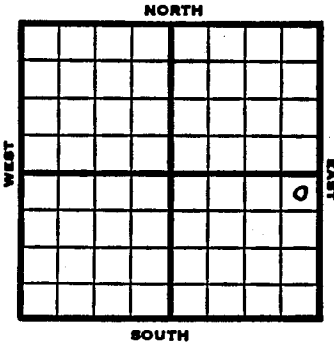

NE NE SE

Carter - acreage

Amerada & Derby - DHM

1953 Elev. 1993' REPORT

6/24 Location

7/1 8" @ 222' w/125 sks

Anhy 1014

Drlg 2076'

7/8 Spud 6-27-53

D&A

TD 3593

8" @ 222

Anhy 1014, Top 2963, Heeb 3192, Lans

3254

DST 3323-45, opn 1 hr., rec. 420'

wtr., 865#,

Arb. 3560

TD 3593

D&A

ABANDONED

Barton KANSAS

Section 35 Township 16 Range 15 W

Well No. # 1 Martz

Company H. E. Zoller & Stearns Pet.

