

County Rush State Kansas
 Sec. 10 (Blk. 16 (Sur. 16W Map No.
 Operator Northern Pump
 Well No. 1 Farm Hopkins
 Elev. _____ Location NE SW NW
 990 Ft. From S Line NW
 990 Ft. From W Line Quarter
 1st. Report APR 2 1952
 Completion _____
 Remarks _____
Northern - Contr.
 Spudding Date _____

Drlg. Data Wildcat

MTR

J. G. McGEHEE

County Rush State Kansas
 Sec. 10 (Blk. 16 (Sur. 16W Map No.
 Operator Northern Pump
 Well No. 1 Farm Hopkins
 Elev. 1960 Location NE SW NW
 990 Ft. From S Line NW
 990 Ft. From W Line Quarter
 1st. Report _____
 Completion APR 23 1952
 Remarks Wildcat
Northern Pump - Contr.
 Spudding Date 4-2-52

Drlg. Data D & A TD 3578

8" @ 905 Top. 2946 Heeb. 3166

Lens. 3222 DST 3270-3300 open 1 hr.

Rec. 50' mud DST 3304-15 open 1 hr.

Rec. 135' water B KC 3452 Cong. 3482

Arb. 3532 DST 3529-33 open 1 hr.

Rec. 10' mud DST 3532-36 open 1 hr.

Rec. 10' mud DST 3540-47 open 1 hr.

Rec. 2160' water TD 3578

D & A

J. G. McGEHEE

Rush KANSAS

Sec. 10 Twp. 16 R. 16 W ✓

Well No. # 1 Hopkins Farm

Northern Pump Company

Northern Wildcat Contractor


Ft. from N. Line

990 Ft. from S. Line

Ft. from E. Line

990 Ft. from W. Line

NE SW NW

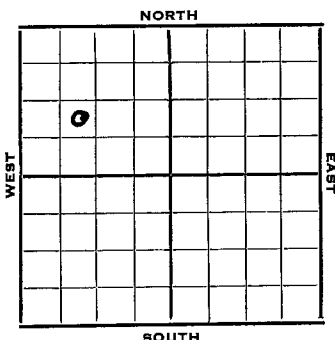

1952

Elev. 1960' REPORT

4/2

MIR

4/9

8" @ 905'

Drlg. 2215'

4/23

Spud 4-2-52

D&A TD 3578 8" @ 905'

Top. 2946 Heeb. 3166 Lans. 3222

DST 3270-3300 open 1 hr. rec. 50' mud

DST 3304-15 open 1 hr. rec. 135' wtr.

B KC 3452 Cong. 3482

Arb. 3532

DST 3529-33 open 1 hr. rec. 10' mud

DST 3532-36 open 1 hr. rec. 10' mud

DST 3540-47 open 1 hr. rec. 2160' wtr

TD 3578 D&A

ABANDONED

FORM 51 25M 8-50 WESTERN Rush

KANSAS

Section 10 Township 16 Range 16W

Well No. #1 Hopkins

Company Northern Pump

