

Rush

Map No. 74 Sec. 13 Twp. 16 R. 16WWell No. 1 LebsackDewee & Brunk Company

Contractor

SECTION PLAT

			0

_____ Ft. from N. Line

320 Ft. from S. Line320 Ft. from E. Line

_____ Ft. from W. Line

FIRST REPORT

Location _____

Rig up _____

Drilling and Remarks:

ROB

RECORD

Cased _____ in., _____ ft.

Sand _____

Gas _____

Oil _____

Total Depth _____

PRODUCTION

1st 24 hrs. Nat. _____

1st 24 hrs. after shot _____

Gas _____ Cu. Ft.

Dry Hole _____

Abandoned _____

Date

MAR 31 1937

S. J. LEWIS

Scout

Rush KANSAS

Map No. 74 Sec. 13 Twp. 16 R. 16WWell No. 1 - LebsackDewee & Brunk Company

Contractor

SECTION PLAT

			0

_____ Ft. from N. Line

330 Ft. from S. Line330 Ft. from E. Line

_____ Ft. from W. Line

Location _____

Rig up _____

Drilling and Remarks:

HFWDVA

RECORD

Cased 5 in., 3470 ft.Sand 511 3492

Gas _____

Oil _____

Total Depth 3512

PRODUCTION

1st 24 hrs. Nat. _____

1st 24 hrs. after shot _____

Gas _____ Cu. Ft.

Dry Hole _____

Abandoned _____

Date

JUL 14 1937


19

H. D. Hatfield

Scout

KANSAS**Rush**Sec. 13 Twp. 16 R. 16-WWell No. #1 Lebsack FarmDawes & Brouk Company Ft. from N. Line330 Ft. from S. Line330 Ft. from E. Line Ft. from W. Line

Elev. 1904

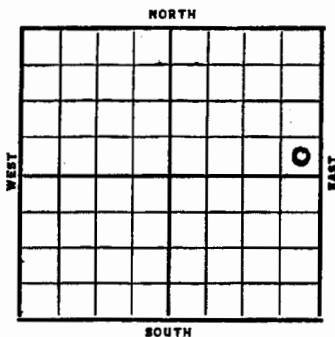

1937

7/9

T.D. 3512' H.F.W.

7/14

5" @ 3470'.

Sil. 3492'.

T.D. 3512'.

H.F.W.

ABANDONED

Date	REPORT
1937	
3/31	R O G
4/8	Rlg
4/16	Rigging up.
4/23	15" @ 356'. WOC.
4/30	T.D. 535'. Rng. 12".
5/7	Anhy 990'. T.D. 992'. U.R. 12".
5/14	12" @ 993'. Drlg. 1380'.
5/21	Drlg. 1985'.
5/28	SD 2389'.
6/4	SD 2650'.
6/11	T.D. 2800'. Rng. 8".
6/19	8" @ 2875'. Topeka 2877'. Drlg. 2930'.
6/25	6" @ 3177'. K.C. 3194'. S.O. 3215 & 3275-80' T.D. U. R. 6".
7/2	Cong. 3425'. 5" @ 3470'. Sil. 3492'. 1500' wat. 3495'. T.D. 3512'. H.F.W. SDO
OVER	

Section.....13.....Township.....16.....Range 16-W.....

Well Number.....1 Lebsack.....

Company.....Deweet Brouk.....

