

Map No. 74 Sec. 14 Twp. 16 R. 16WWell No. 1 SupperShoenfeldt & Pitch Company
Contractor

SECTION PLAT

 Ft. from N. Line320 Ft. from S. Line Ft. from E. Line320 Ft. from W. Line

FIRST REPORT

Location Rig up

Drilling and Remarks:

ROG

RECORD

Cased in., ft.Sand Gas Oil Total Depth

PRODUCTION

1st 24 hrs. Nat. 1st 24 hrs. after shot Gas Cu. Ft.Dry Hole Abandoned

Date

FEB 17 1937

19

S. J. LEWIS

Scout

Map No. 74 Sec. 14 Twp. 16 R. 16WWell No. 1 - SupperShoenfeldt et al Company
Contractor~~ABANDONED~~
COMPLETED

SECTION PLAT

 Ft. from N. Line330 Ft. from S. Line Ft. from E. Line330 Ft. from W. LineLocation Rig up

Drilling and Remarks:

D & A

RECORD

Cased 6 in., 3249 ft.Sand K.C. 3249Gas Oil Total Depth 3446

PRODUCTION

1st 24 hrs. Nat. 1st 24 hrs. after shot Gas Cu. Ft.Dry Hole Abandoned

Date

MAY 19 1937

19

H. D. Hatfield

Scout

Rush KANSAS
 Map No. *74* Sec. *14* Twp. *16* R. *16*^W
 Well No. *1 - Suppes*
Shoenfeldt & Kitch Company

FIRST REPORT

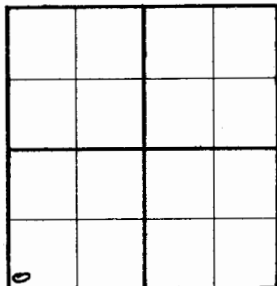
Contractor

COMPLETED

Ft. from N. Line

330 Ft. from S. Line

Ft. from E. Line

330 Ft. from W. Line**SECTION PLAT**

Location

Rig up

Drilling and Remarks:

*O.W.D.D.**O.T.O. 3446**@ 3555 - Pat 292**@ 3559 - no increase***RECORD**Cased *5" Liner* in., *3512 ft.*Sand *cong 3476*Gas *Sil - 3557*

Oil

Total Depth *3559***PRODUCTION**

1st 24 hrs. Nat.

1st 24 hrs. after shot

Gas _____ Cu. Ft.

Dry Hole

Abandoned

Date

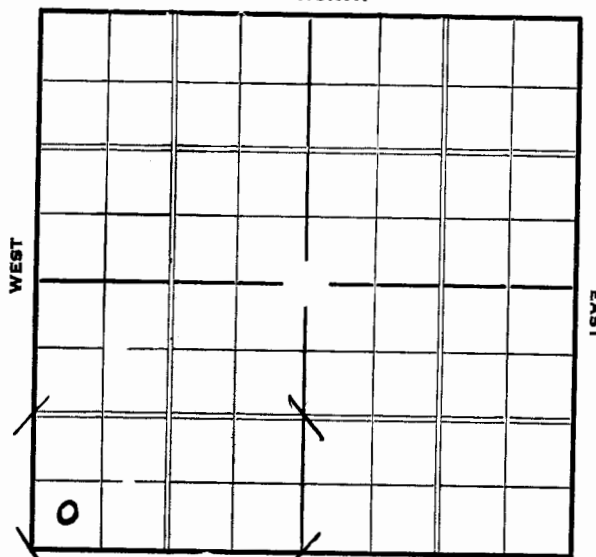
JUN 16 1937 19

H. H. Batfield

Scout

*Rush*Section *14* Township *16* Range *16-W*Well Number *1 Suppes*Company *Shoenfeldt & Pitch*

NORTH

SOUTH
O.W.D.D.