FORM 275 FOR SALE BY KANSAS BLUE PRINT CO.


County Rush State Kansas

Sec. 15 (Blk. Twp.) 16 (Sur. Rge.) 16W Map No.

Operator Carl Lebsack

Well No. 1 Farm Brack

Elev. Location NE NE SE

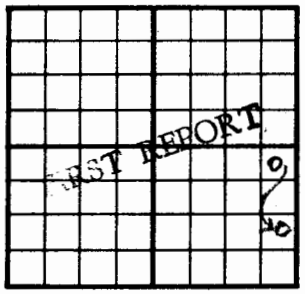

330 Ft. From N Line SE

330 Ft. From E Line Quarter

1st. Report OCT 11 1950

Completion

Remarks Glenn Nye - Contr.

Spudding Date 10-10-50

Drlg. Data Winget Pool

drlg. 750

J. E. TYRA

Form 26 200 Bks. 11-49 Petrol

Kansas

Map No. Sec. 15 Twp. 16 R. 16W


Well No. 1 Brack

Carl Lebsack Company

CORRECTION Contractor

NE SE SE

SECTION PLAT

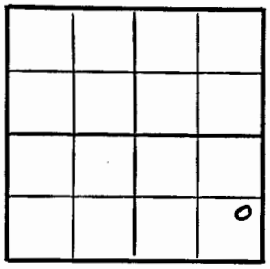

Ft. from N. Line

990 Ft. from S. Line

330 Ft. from E. Line

Ft. from W. Line

Rush County

Location

Rig up

Drilling and Remarks:

Reported

NE NE SE

RECORD

Cased in., ft.

Sand

Gas

Oil

Total Depth

PRODUCTION

1st 24 hrs. Nat.

1st 24 hrs. after shot

Gas Cu. Ft.

Dry Hole

Abandoned

Date

OCT 16 1950 19

J. E. TYRA Scout

FORM 275 FOR SALE BY KANSAS BLUE PRINT CO.


County Rush State Kansas

Sec. 15 (Blk. Twp.) 16 (Sur. Rge.) 16W Map No.

Operator Carl Lebsack

Well No. 1 Farm Brack

Elev. 1927 Location NE SE SE

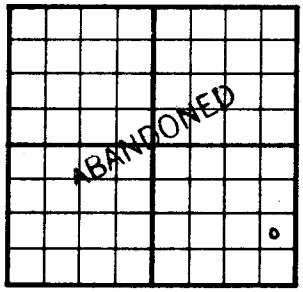

990 Ft. From S Line SE

330 Ft. From E Line Quarter

1st. Report

Completion DEC 6 1950

Remarks Winget Pool

Glenn Nye - Contr.

Spudding Date 10-10-50

Drlg. Data D & A TD 3540

Anhy 1040 8 5/8" @ 1052 KC 3230

Arb. 3526 5" @ 3526 TD 3540 HFW

D & A

J. E. TYRA

FORM 252-B
10M 9-49 PETROL

KANSAS Rush

Sec. 15 Twp. 16 R. 16-W

Well No. #1 Brack Farm

Carl Lebsack Company

Glenn Nye Contractor

Winget


~~330~~ Ft. from N. Line

990 Ft. from S. Line

330 Ft. from E. Line

Ft. from W. Line

NE ~~NE~~ SE

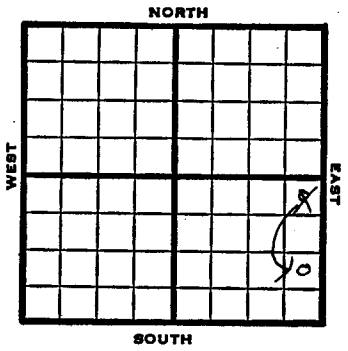

1950	Elv. 1927' REPORT
10/11	Spud 10-10-50 drlg 750
12/6	Spud 10-10-50 D&A TD 3540 Anhy 1040' 8-5/8" @ 1052' KC 3230' Arb. 3526 5" @ 3526' TD 3540 HFW D&A ABANDONED

FORM 51 25M 8-50 WESTERN Rush KANSAS

Section 15 Township 16 Range 16W

Well No. #1 Brack

Company Carl Lebsack

