

Map No. 74 Sec. 22 Twp. 16 R. 16W

Well No. 1 Wagner

Texas Company

Contractor

SECTION PLAT

			0

330 Ft. from N. Line

_____ Ft. from S. Line

330 Ft. from E. Line

_____ Ft. from W. Line

FIRST REPORT

Location _____

Rig up _____

Drilling and Remarks:

Cellar

RECORD

Cased _____ in., _____ ft.

Sand _____

Gas _____

Oil _____

Total Depth _____

PRODUCTION

1st 24 hrs. Nat. _____

1st 24 hrs. after shot _____

Gas _____ Cu. Ft.

Dry Hole _____

Abandoned _____

Date
JAN 20 1937

S. J. LEWIS Scout

Map No. 74 Sec. 22 Twp. 16 R. 16W

Well No. 1 Wagner

Texas Company

Contractor

SECTION PLAT

			0

330 Ft. from N. Line

_____ Ft. from S. Line

330 Ft. from E. Line

_____ Ft. from W. Line

DELETED

Location _____

Rig up _____

Drilling and Remarks:

*KC Line 3251
P.B. 3257
1000 acid
Potential 491 oil
100 water*

RECORD

Cased _____ in., _____ ft.

Sand _____

Gas _____

Oil _____

Total Depth 3274

PRODUCTION

1st 24 hrs. Nat. _____

1st 24 hrs. after shot _____

Gas _____ Cu. Ft.

Dry Hole _____

Abandoned _____

Date
APR 1 ± 1937

S. J. LEWIS Scout

Sec. 22 Twp. 16 R. 16-W

Well No. #1 Wagner Farm

Texas Company


330 Ft. from N. Line

_____ Ft. from S. Line

330 Ft. from E. Line

_____ Ft. from W. Line

Elev. 1941

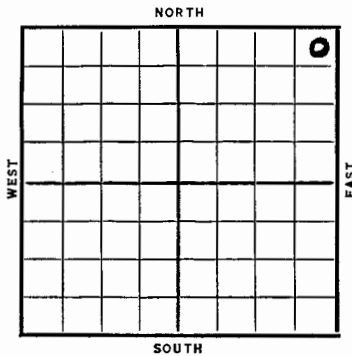

Date	REPORT
1937	
1/20	Cellar
1/28	R O G
2/4	Rig
2/11	Rigging up
2/19	15" @ 80. Drlg. 1055'.
2/26	Drlg. 1370'.
3/4	Drlg. 2825'.
3/11	KCL 3251'. Set 8" @ 3254'. RUST
3/18	" " " " " "
3/25	T.D. 3272' water. P.B. 3258'.
4/2	T.D. 3274'. Plug back 3257'.
4/8	1000 acid. Potential 497 Oil
	100 water.
4/14	K. C. Lime 3251'.
	T.D. 3274'.
	P.B. 3257'.
	1000 acid.
	Potential 491 oil, 100 water.
	COMPLETED

Section 22 Township 16 Range 16W

Well Number 1 Wagner

Company Texas

