

Map No. 74 Sec. 23 Twp. 16 R. 16WWell No. 1 Brack.C. B. Davis Company

Contractor

SECTION PLAT

0			

330 Ft. from N. Line

Ft. from S. Line

Ft. from E. Line

330 Ft. from W. Line

FIRST REPORT

Location

Rig up

Drilling and Remarks:

Rig

RECORD

Cased in., ft.

Sand

Gas

Oil

Total Depth

PRODUCTION

1st 24 hrs. Nat.

1st 24 hrs. after shot

Gas Cu. Ft.

Dry Hole

Abandoned

Map No. 74 Sec. 23 Twp. 16 R. 16WWell No. 1-BrackC. B. Davis Company

Contractor

ABANDONED

SECTION PLAT

0			

330 Ft. from N. Line

Ft. from S. Line

Ft. from E. Line

330 Ft. from W. Line

Location

Rig up

Drilling and Remarks:

H.F.W.D. & A.

RECORD

Cased in., ft.

Sand lime 35W-72Gas Granite Wash 3572

Oil

Total Depth 3612

PRODUCTION

1st 24 hrs. Nat.

1st 24 hrs. after shot

Gas Cu. Ft.

Dry Hole

Abandoned

Date

MAR 10 1937 19

S. J. LEWIS

Scout

Date

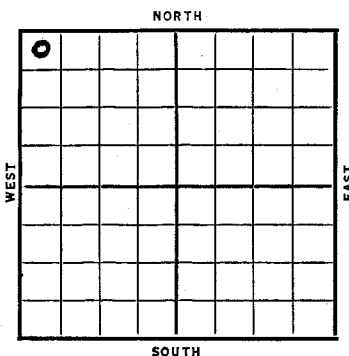
MAY 12 1937 19

H. D. Hatfield

Scout

KANSAS

Rush

Sec. 23 Twp. 16 R. 16-WWell No. #1 Brack FarmC. B. Davis Company330 Ft. from N. Line Ft. from S. Line Ft. from E. Line330 Ft. from W. Line

Date	REPORT
1937	
3/10	Rig
3/18	Surface hole
3/25	15" @ 70'. 10" @ 1008'.
4/2	Drlg. 2510'.
4/8	Drlg. 3242'
4/16	KC Lime 3255½'.
	7" @ 3256'. RUST.
4/23	Fishing 3292'.
4/30	Small show oil 3465-66'.
	Drlg. 3486'.
5/7	T.D. 3551'. Drlg. by tools.
5/12	Lime 3570-72'.
	Granite wash 3572'.
	T.D. 3612'.
	ABANDONED

KANSAS

Rush

Section 23 Township 16 Range 16-WWell Number 1 BrackCompany C.B.Davis