

Rush

KANSAS ✓

Sec. 4 Twp. 16 R. 17W

Well No. #1 Burgardt Farm _____

Overland Drlg. Company _____

Wildcat Contractor _____


330 Ft. from N. Line

_____ Ft. from S. Line

_____ Ft. from E. Line

330 Ft. from W. Line

NW NW SE

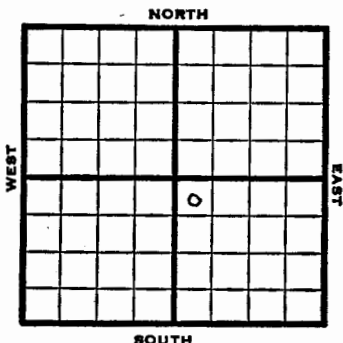

1952

Elev. 1978'

REPORT

9/4 Cellar & Pits

9/10 MI

9/17 Anhy 1123'
8" @ 1128'

9/24 NR

10/1 Spud 9-11-52
D & A TD 3550' Anhy 1123'
8" @ 1128 Heeb 3232' Lans. 3280'
DST 3294-3385 open 2 hr, rec 170' SW
& mud 950# Arb. 3537'
DST 3538-50 open 1 hr. rec 520' SGCM
430# D & A

ABANDONED

Rush KANSAS

Section 4 Township 16 Range 17 W

Well No. #1 Burgardt

Company Artwell Oil Co.

Overland Drlg.

