


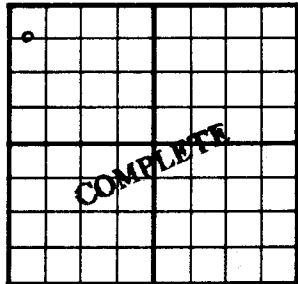

Sec. 6 Twp. 16 R. 17W

County Rush State Kansas  
 Sec. 6 (Blk. 16) (Sur. 17W) Map No.  
 Operator Kelinson & Bradley  
 Well No. 1 Farm Pfiefer  
 Elev. 1899 Location C W L NW NW



660 Ft. From N Line NW  
330 Ft. From W Line Quarter  
 1st. Report  
 Completion JAN 2 1952  
 Remarks Wildcat  
Speer Drlg. - Contr.  
 Spudding Date 10-14-51

Drlg. Data Oil well TD 3512


8 5/8" @ 909 Anhy 1055 Heeb. 3144  
Lans. 3198 DST 3202-46 open 45 min.  
Rec. 50' mud DST 3344-66 open 1/2 hr.  
Rec. 1675' free oil Arb. 3447 DST 3448-58  
open 1/8 hr. est 4 mcfg DST 3467-73  
open 1/2 hr. Rec. 70' ocm 120' water  
1 mcfg Basil sand 3502 TD 3512  
5" @ 3506 CO to 3512 FU 2500' water 2 hr  
SP 3496 ~~23/ 3344-51~~ 23/ 3344-51  
FU 1000' oil Comp. 160 bopd

J. E. TYRA

Well No. #1 Pfiefer Farm  
Kelinson & Bradley Company

Speer - Contr. Contractor  
Wildcat

660  
330 Ft. from N. Line  
 \_\_\_\_\_ Ft. from S. Line  
 \_\_\_\_\_ Ft. from E. Line  
330 Ft. from W. Line  
NW NW NW  
C W L NW NW

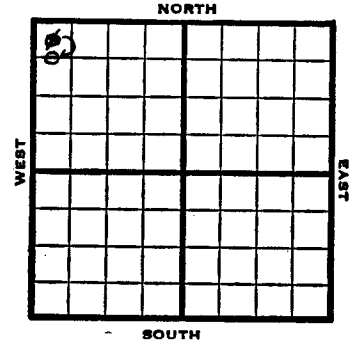

1951	Elev. 1899'	REPORT
10/17	Drlg. 320'	
	Spud 10-14-51	
1952		
1/2	Spud 10-14-51	
	Oil Well	TD 3512
	8-5/8" @ 909'	
	Anhy 1055	Heeb. 3144
	Lans. 3198	
	DST 3202-46 open 45 min.	
	Rec. 50' mud	
	DST 3344-66 open 1/2 hr. Rec. 1675'	
	free oil	
	Arb. 3447	
	DST 3448-58 open 1/8 hr. est. 4 MCFG	
	DST 3467-73 open 1/2 hr. rec. 70' OCM	
	120' wtr. 1 MCFG	
	Basil sd 3502	TD 3512
	5" @ 3506 CO to 3512	
	FU 2500' wtr. 2 hr. SP 3496	
	23/ 3344-51 FU 1000' oil	
	Comp. 160 BOPD	

COMPLETED

Section 6 Township 16 Range 17W

Well No. #1 Pfiefer

Company Kelinson & Bradley

