

# WILDCAT

FORM 513 SUNRAY

County Rush Elev. \_\_\_\_\_  
 Sec. 11 Top. 16 Rge. 17W  
 Company Iron Drlg.  
 Farm Name Stegman No. 1

TOPS	DEPTH	LOG	DATUM	Loc. in Sec.
Ans.				NW NW NW
Tp.				
H.				
Tr.				
Dg.				
Bl.				
L.				Geol.
K.C.				Contr.
B.K.C.				Co. tools
Ce.				Pool
C.				Wildcat
M.				
M.				
K.				
Mz.				
Mo.				
V.				
S.				
S.				
A.				
R.				
PC.				
G.				
TR.				

Date Comm. 11-1-56  
8" @ 1128/500 WOC

DEC 5 1956  
**FIRST REPORT**

FORM 513 SUNRAY

County Rush Elev. 1981 DF  
 Sec. 11 Top. 16 Rge. 17W  
 Company Iron Drlg.  
 Farm Name Stegman No. 1

TOPS	DEPTH	LOG	DATUM	Loc. in Sec.
Ans.				NW NW NW
Tp.				
H.	<u>3234</u>	<u>3236</u>		
Tr.	<u>3254</u>	<u>3256</u>		
Dg.				
Bl.				
L.	<u>3286</u>	<u>3289</u>		Geol.
K.C.				Contr.
B.K.C.		<u>3509</u>		Co. tools
Ce.				Pool
C.		<u>3528</u>		Wildcat
M.				
M.				
K.				
Mz.				
Mo.				
V.				
S.				
S.				
A.	<u>3544</u>	<u>3546</u>		
R.				
PC.				
G.				
TR.	<u>3594</u>			

Date Comm. 11-1-56  
8" @ 1128/500 WOC DEC 12 1956 @ 3382

DEC 19 56 DST 3352-85 1 hr run  
 75' HO CM FP 0-55 BHP  
 590/20" DST 3440-70 40 45"  
 run 40' MSW FP 0 BHP 1070  
 120" DST 3546-50 2 hr run  
 65' gas + 60' HO CM + 30' OCME  
 wt BHP 45/20" DIT 3550-69  
 90" run 3' oil + 380' SW BHP 880/200"  
 D&A

**ABANDONED**

# WILDCAT

Section 11 Township 16 Range 17W


Well No. #1 Stegman

Company ~~Irwin Drilling~~ Bennett & Roberts

FORM 513 SUNRAY

County Rush Elev. \_\_\_\_\_  
 Sec. 11 Twp. 16 Rge. 17W  
 Company Bennett & Roberts  
 Farm Name Stegman No. 1

TOPS	DEPTH	LOG	DATUM	Loc. in Sec.
Anh.				NW NW NW
Tr.				(OWO)
Dg.				
Bl.				
L.				Geol.
K.C. <u>LKC</u>	<u>3289</u>			Cont.
B.K.C.				<u>Bennett &amp; Roberts</u>
Ce.				Pool
C.	<u>3528</u>			<u>Wildcat</u>
M.				
M.				
K.				
Mz.				
Me.				
V.				
S.				
S.				
A.	<u>3546</u>			FIRST REPORT
R.				
Pe.				
G.				
TD	<u>OTD</u>	<u>3694</u>		Ann 28 57

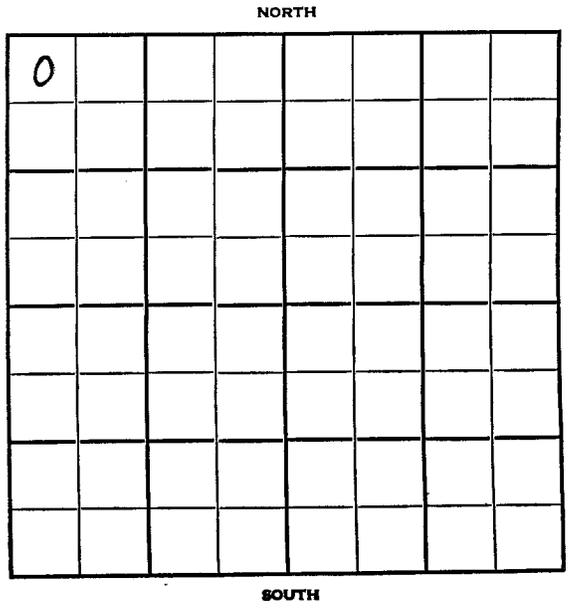

Date Comm. Was #1 Stegman - D & A  
 New Info - MIET DD 3605, TD 5" @ 3604/100

0470

County <u>Rush</u> Elev. _____			
Sec. <u>11</u> Imp. <u>16</u> Rgs. <u>17W</u>			
Company <u>Bennett &amp; Roberts</u>			
Farm Name <u>Stegman</u>		No. <u>1</u>	
TOPS	DEPTH	LOG	DATUM
Ann.			
Tr.			
H.			
Tr.			
Dg.			
Bl.			
L.			
K.C. <u>LKC</u>	<u>3289</u>		
B.K.C.			
Ce.			
C.	<u>3528</u>		
M.			
K.			
Mz.			
Mo.			
V.			
S.			
S.			
A.	<u>3516</u>		
R.			
PE.			
G.			
TD.	<u>OTD</u>	<u>3691</u>	

Loc. in Sec. NW NW NW  
(CWWO)

Geol. \_\_\_\_\_  
 Contr. \_\_\_\_\_  
 Co. Bennett & Roberts  
 Pool Stegman  
Wildcat Disc

NOV 6 '57
<b>ABANDONED</b>

Date Comm. Was #1 Stegman - D & A  
 New Info - MIRT DD 3605, TD 5" @ 3604/100  
 SEP 4 '57 11 in SEP 1 '57 11 in  
 18/3547-50 SSO 500A  
 \$ 10 BW ph + SSO PB 3541  
 14/3528-31 \$ 22.68 9.0 + 2.54  
 9.4 ph nat 500A \$ 3690 ph  
 + tr w 11 \$ 12.6 \* BW ph + SSO  
 PB 3510 24/3499-3503 500A  
 \$ 7.32 BW ph nat PB 3492

25/3485-89 500A 5 gwph  
 no oil PB 3390 17/3365-68  
 \$ 12.90 + 6 gwph nat line  
 1) \$ 1.32 BW ph + Lot w  
 2) \$ 1.75 130 ph + Lot w  
 PB 3360 18/3356-59 11 2.66  
 Boph nat PB 3340 14/3325-31  
 2) no oil CO 3390 \$ 1.32 Boph  
 + lots w 10x  
 OCT 4 '57 NOV 10 '57  
 NOV 25 '57 P 5 Boph + lots water

T & A

11-16-17W - NW NW NW