

County Rush Elev. 1966				Co.	
Sec. 11 Twp. 16 Rge. 17W					
Company Davis Bros. & Prime Drlg.					
FarmName Breit No. 1					
TOPS	DEPTH	LOG	DATUM	Loc. in Sec.	Lse.
Anh.				SE SE SE	
Tr.					
H.					
Tr.					
Dg.					
Bl.					
L.				Geol.	
K.C.				Contr.	
B.K.C.				Prime	
Ce.				Pool	
C.				Wildcat	
M.					
M.					
K.					
Mz.					
Ma.					
V.					
S.					
S.					
A.					
R.					
Pe.					
G.					
Date Comm. 12-7-55 Sun - DHM				No.	
8" @ stuck @ 2289				Sec.	
				T.	
				R.	

County Rush Elev. 1966				Co.	
Sec. 11 Twp. 16 Rge. 17W					
Company Davis Bros. & Prime Drlg.					
FarmName Breit No. 1					
TOPS	DEPTH	LOG	DATUM	Loc. in Sec.	Lse.
Anh.				SE SE SE	
Tr.					
H.	3216		1250		
Tr.	3234		1268		
Dg.					
Bl.					
L.	3269		1303	Geol.	
K.C.				Contr.	
B.K.C.				prime	
Ce.	3536		1510	Pool	
C.				Wildcat	
M.					
M.					
K.					
Mz.					
Ma.					
V.					
S.					
S.	3563		1547		
A.					
R.					
Pe.					
G.					
Date Comm. 12-7-55 DEC 28 1955				No.	
8" @ 1103 DST 2968-98 open 1 hr.				Sec.	
rec. 20' mud 0# DST 3395-3434				T.	
failed DST 3395-3434 open 1 hr.				R.	
rec. 80' wcm 900/20" DST 3445-80					
open 1 hr. rec. 40' hocm 1100/20"					
DST 3507-70 open 1 hr. rec. 40' wcm					
700#					
D & A					

WILDCAT

FORM 513 SUNRAY

County Rush		Elev. 1966 DF	
Sec. 11	Temp. 16S	Rge. 17W	
Company Bennett & Roberts			
Farm Name Breit No. 1			

TOPS	DEPTH	LOG	DATUM	Loc. in Sec.
Anh.				SE SE SE
Tr.				
H.				
Tr.				
Dg.				
BL KC	3269			Geol.
L.				Contr.
K.C.				
B.K.C.				
Ce.	3536			
C.				
M.				
M.				
K.				
Mz.				
Me.				
V.				
S.				
S.				
A.	3563			
R.				
Pe.				
G.				
TD				

Geol. **WC**

Contr. **WC**

Pool **WC**

FIRST REPORT

AUG 7 '57

Date Comm. **OWWO**

Old info - was Davis & Prime; OTD 3595;
D & A

New info - CO. Tools - MIRT to DD 3596 TD;
5" 3886 w/100 sx; WOCT

FORM 513 SUNRAY

County Rush		Elev. 1966 DF	
Sec. 11	Temp. 16S	Rge. 17W	
Company Bennett & Roberts			
Farm Name Breit No. 1			

TOPS	DEPTH	LOG	DATUM	Loc. in Sec.
Anh.				SE SE SE
Tr.				
H.				
Tr.				
Dg.				
BL KC	3269			Geol.
L.				Contr.
K.C.				
B.K.C.				
Ce.	3536			
C.				
M.				
M.				
K.				
Mz.				
Me.				
V.				
S.				
S.				
A.	3563			
R.				
Pe.				
G.				
TD				

Geol. **WC**

Contr. **WC**

Pool **WC**

COMPLETE

SEP 4 '57

Date Comm. **OWWO**

Old info - was Davis & Prime; OTD 3595;
D & A

New info - CO. Tools - MIRT to DD 3596 TD;
5" 3886 w/100 sx; WOCT

24/3466

172 172 17 Boph no/w 4

has grav 38°

AUG 28 '57

SEP 4 '57

Ph P. 44 Boph no/w

grav 42°

O.W.W.O.

Rush

KANSAS

SEC. 11	TWP. 16	R. 17W
------------	------------	-----------

#1 Breit

FARM

 COMPANY Bennett + Roberts
Davis Bros. & Prime Drlg.

CONTRACTOR

Prime

WILDCAT


Ft. from N. Line

Ft. from S. Line

Ft. from E. Line

Ft. from W. Line

SE SE SE

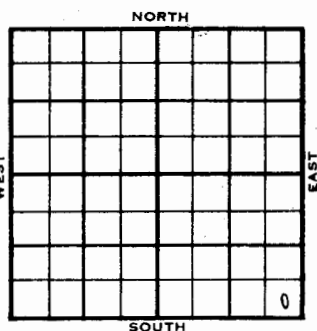

Sun - DHM

1955	ELEVATION 1966	REPORT
12-14	Comm. 12-7-55 8" @ stuck @ 2289	
12-20	DST 2968-98 op 1 hr. rec. 20' mud, 0# DST 3395-3434 failed DST 3395-3434 op 1 hr. rec. 80' wcm 900/20" DST 3445-80 op 1 hr. rec. 40' hocm, 1100/20" DST 3507-70 op 1 hr. rec. 40' wm, 700# D & A H. 3216 Tr. 3234 L. 3269 C. 3536 A. 3563 TD 3595'	
		ABANDONED

DX-78

DX-78

O.W.W.O.

Rush

KANSAS

SECTION 11	TOWNSHIP 16	RANGE 17 W
---------------	----------------	---------------

WELL NO. #1 Breit

 COMPANY Bennett + Roberts
Davis Bros. & Prime Drlg.
