

Rush

KANSAS

SECTION 14 TOWNSHIP 16 RANGE 17W


WELL NO. #1 Kuhn "B"

COMPANY Jones, Shelburne & Farmer

FORM 513 SUNRAY


WILDCAT

County Rush Elev. _____
 Sec. 14 Twp. 16 Rge. 17W
 Company Jones, Shelburne & Farmer
 Farm Name Kuhn "B" No. 1

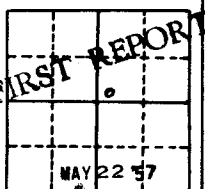TOPS	DEPTH	LOG	DATUM	Loc. in Sec.
Anh.				SW SW NE
Tr.				
H.				
Tr.				
Dg.				Geol. _____
Bl.				
L.				Contr. _____
K.C.				
B.K.C.				Pool _____
Ce.				
C.				Wildcat FIRST REPORT  MAY 22 57
M.				
M.				
K.				
Sp.				
Ma.				
V.				
S.				
S.				
A.				
R.				
Pe.				
G.				
TD				

Date Comm. CSO, Texas & Aurora DHM

Location _____

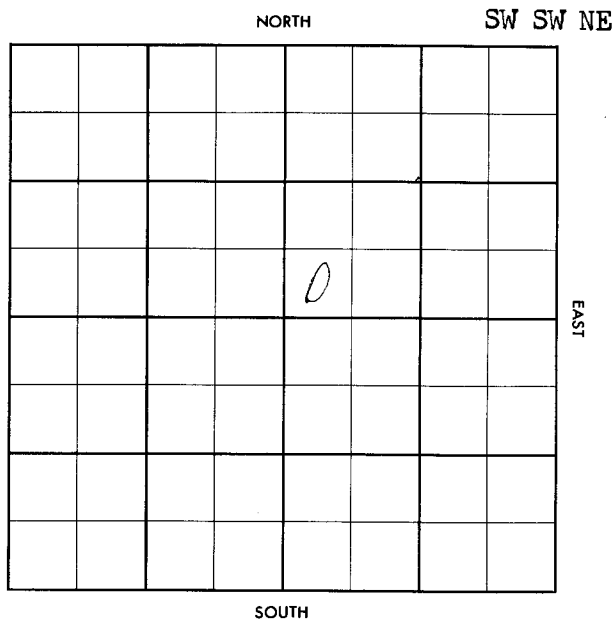

County Rush Elev 1962
 Sec 14 Twp 16 Rge 17W
 Company Jones, Shelburne & Farmer
 Farm Name Kuhn "B" No 1

TOPS	DEPTH	LOG	DATUM	Loc. in Sec.
	1098			SW SW NE
Ask				
Tp				
H	3207			
Tc	Dodge 3325			
Dp				
Bl				
L	3260			
KC				
BKC	3482			
Ce				
C	3514			Geol.
M				Contr.
M				Lorito
K				Pool
Me				Wildcat
Ma				
V				
S				
S				
A	3525			COMPLETE
R				
PC				
Q				
TD	3547			SEP 25 57

Date Comm: CSO, Texas & Aurora-DHM
 Location MAY 29 57 5-22-57 85/8
3528/200 D 2170 JUN 5 57
DST 3333-45' 1hr 15' Md
+550 BHT 860/20 DST 3410-20
1hr G/1hr res 160' HOCM + 20'
oil + 70' M oil 360/20" DST
3528-34 1hr 70' Md 8. Wt BHT
0 Log 5 1/2 3547/ JUN 12 57 JUN 13 57
CO ~~PF~~ PF/3452-59 11/2 8

35 Boph 5 hrs now T&R
POT P 100 BOPD now
LSG 3452-59
37° 9'

14-16-17 W SW SW NE