

Rush

Map No. KANSAS Sec. 19 Twp. 16 R. 17W

Well No. 1 Urban

Joe. Bergen etal. Company

FIRST REPORT Contractor

SE NE SE


SECTION PLAT

990 Ft. from N. Line

_____ Ft. from S. Line

330 Ft. from E. Line

_____ Ft. from W. Line

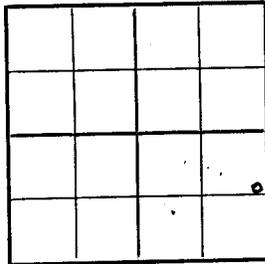

WILDCAT

Location XXX

Rig up _____

Drilling and Remarks: _____

RECORD

Cased _____ in., _____ ft.

Sand _____

Gas _____

Oil _____

Total Depth _____

PRODUCTION

1st 24 hrs. Nat. _____

1st 24 hrs. after shot _____

Gas _____ Cu. Ft.

Dry Hole _____

Abandoned _____

Date

JUN 16 1943 19 S. J. LEWIS Scout

Rush

Map No. KANSAS Sec. 19 Twp. 16 R. 17W

Well No. 1 Urban

Falcon-Seaboard etal. Company

CORRECTION Contractor

SE NE SE


SECTION PLAT

990 Ft. from N. Line

_____ Ft. from S. Line

330 Ft. from E. Line

_____ Ft. from W. Line

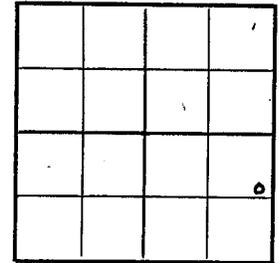

WILDCAT

Location _____

Rig up _____

Drilling and Remarks: _____

Reported as

Joe Bergen etal.

RECORD

Cased _____ in., _____ ft.

Sand _____

Gas _____

Oil _____

Total Depth _____

PRODUCTION

1st 24 hrs. Nat. _____

1st 24 hrs. after shot _____

Gas _____ Cu. Ft.

Dry Hole _____

Abandoned _____

Date

JUN 23 1943 19 S. J. LEWIS Scout

KANSAS
Map No. 74 Sec. 19 Twp. 16, R. 17W

Well No. 1 Urban

Falcon Seaboard etal. Company

ABANDONED Contractor

SE NE SE


SECTION PLAT

990 Ft. from N. Line

_____ Ft. from S. Line

330 Ft. from E. Line

_____ Ft. from W. Line

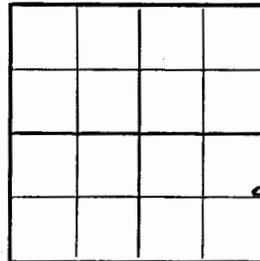

WILDCAT

Location _____

Rig up _____

Drilling and Remarks:

Liams 3288
Quartzite 3491

RECORD

Cased _____ in., _____ ft.

Sand _____

Gas _____

Oil _____

Total Depth 3522

PRODUCTION

1st 24 hrs. Nat. _____

1st 24 hrs. after shot _____

Gas _____ Cu. Ft.

Dry Hole _____

Abandoned _____

Date

JUL 28 1943 19

S. J. LEWIS Scout

KANSAS

Rush

Sec. 19 Twp. 16 R. 17-W

Well No. #1 Urban Farm
Falcon-Seaboard et al.
Joe Bergen et al. Company

Wildcat


990 Ft. from N. Line

_____ Ft. from S. Line

330 Ft. from E. Line

_____ Ft. from W. Line

Elev. 2025

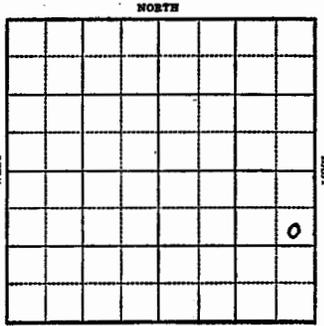

1943

REPORT

6/16 Location.

6/23 Derrick

6/30 "

7/7 "

7/15 "

7/21 Anhy 1107
Drlg. 2640'

7/28 Lans 3288
Quartzite 3481
T.D. 3522'

ABANDONED


KANSAS

Rush

Section 19 Township 16 Range 17-W

Well No. #1 Urban
Falcon-Seaboard et al.
Joe Bergen et al. Company

NORTH

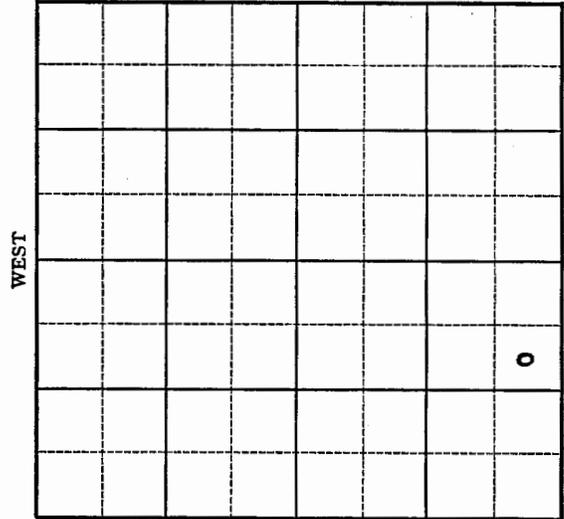

SOUTH